

LAFAYETTE MISSISSIPPI BOARD OF WATER COMMISSIONERS

J 14  
8-16-62

WATER WELL DRILLERS LOG

LA FAYETTE

Date: 8/16, 1962, Driller: H H Well Co

(Name: H C Henderson)

**CODED**

(1) Owner of Land: John E. Johnson  
(Name)  
R.F.D. Taylor mining  
(Address)  
2 95 SW  
(2) Location: 1/4, 1/4, Sec. J R  
15 miles SW of Oxford  
(distance) (direction) (Nearest Town)  
(3) Topography: A  
(Hilly) (Flat) (Level)  
(4) Purpose of Well: Drinking Water  
(Domestic Irrigation, Municipal, Industrial, Other)

Description & Color of Materials Sand, Clay, Red Clay, Shell, etc.	Thick- ness Feet	Depth Feet
<u>4" Red clay</u>	<u>4</u>	<u>69</u>
<u>Red sand</u>	<u>20</u>	
<u>stratified white clay</u>	<u>6</u>	
<u>30" white sand</u>		


**CODED**

Information upon completion of well:

(1) Diameter 2" inches.  
(2) Total Depth 69 feet.  
(3) Water Level 21 feet below top of ground.  
(4) Cased to 63, Size 2  
(5) Screen: Size 1 1/4, Length 6  
(6) Were any formations sealed against pollution?  
\_\_\_\_\_ yes, \_\_\_\_\_ no.

#2 well  
Wood seal  
0052  
Jet Pump  
12 gal min.

If YES depth of formation \_\_\_\_\_  
Why \_\_\_\_\_  
Drillers Remarks: \_\_\_\_\_

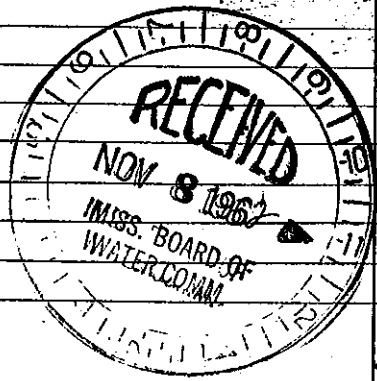

22 Well No.

(Use Back Side)

Retain this copy for your office files.