

LAFAYETTE

MISSISSIPPI BOARD OF WATER COMMISSIONERS

J15

8-17-62

WATER WELL DRILLERS LOG

LAFAYETTE

Date: 8-17, 1962, Driller: H.H. Well Co

COBED

AC, Henderson


(1) Owner of Land:	Description & Color of Materials Sand, Clay, Red Clay, Shell, etc.	Thick- ness Feet	Depth Feet
Jim & Leta R.F.D. 1, Taylor Miss. (Name) (Address)	4' Red clay 30' Red Sand Streak white clay	4 30 4	90
(2) Location: 1/4, 1/4, Sec. T. R. 15 miles S.W. of Oxford (distance) (direction) (Nearest Town)	Bal sand		
(3) Topography: <input checked="" type="checkbox"/> (Hilly) <input type="checkbox"/> (Flat) <input type="checkbox"/> (Level)			
(4) Purpose of Well: Home (Domestic Irrigation Municipal, Industrial, Other)			

COBED

Information upon completion of well:

- (1) Diameter 2" inches.
- (2) Total Depth 90' feet.
- (3) Water Level 70' feet below top of ground.
- (4) Cased to 84', Size 2
- (5) Screen: Size 1 1/4", Length 6
- (6) Were any formations sealed against pollution?
_____ yes, _____ no.

#1 well
Red Pump
#0052

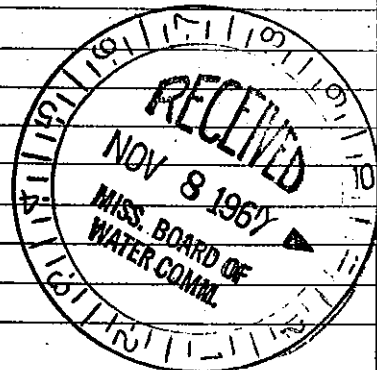

(Use Back Side)

Well No. 21

Retain this copy for your office files.