

MISSISSIPPI BOARD OF WATER COMMISSIONERS

LAFAY.  
J20

LAF.

WATER WELL DRILLERS LOG

Date: 11-23-61, 1961, Driller: J B CAIN County: PANOLA

(Name)

(1) Owner of Land: TIDWELL  
(Name)  
BATESVILLE, MISS.  
(Address)  
Center of Sec 34

(2) Location: 1/4, 1/4, Sec. 34 T. 9 S. R. 5 W.  
14 miles S.W. of OXFORD  
(distance) (direction) (Nearest Town)

(3) Topography: HILLY  
(Hilly) (Flat) (Level)

(4) Purpose of Well: HOME  
(Domestic Irrigation  
Municipal, Industrial, Other)

Description & Color of Materials  
Sand, Clay, Red Clay, Shell, etc.

Thick-  
ness  
Feet

Depth  
Feet

Sand  
WATER SAND 0 130  
130 149


Information upon completion of well:

- (1) Diameter: 2" inches.  
(2) Total Depth: 149 feet.  
(3) Water Level: 78 feet below top of ground.  
(4) Cased to: 149, Size: 2"  
(5) Screen: Size: 1/4, Length: 6.  
(6) Were any formations sealed against pollution?  
yes, ☒ no.

If YES depth of formation

Why

Drillers Remarks: NON

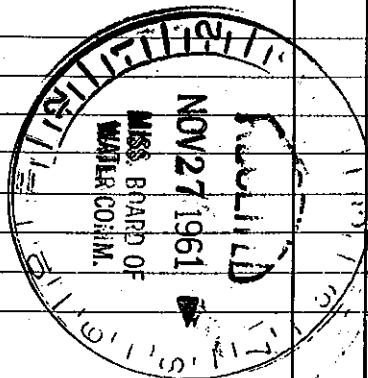

(Use Back Side)

Well No.

Mail this copy to Board of Water Commissioners 429 Miss. St. Jackson, Miss.