

LAF.  
J 21  
4-24-62

MISSISSIPPI BOARD OF WATER

WATER WELL DRILLERS LOG

Date: 4/24, 1962, Driller: ELLIOTT HARDWARE COMPANY  
OXFORD, MISSISSIPPI County Lafayette  
(Name)

(1) Owner of Land:	Description & Color of Materials Sand, Clay, Red Clay, Shell, etc.	Thick- ness Feet	Depth Feet
(Name) <u>Mrs. Tyson</u> (Address) <u>RT 2 - Taylor</u>	<u>Red Clay</u>	<u>63</u>	<u>63</u>
(2) Location: <u>1/4</u> , <u>1/4</u> , Sec <u>22 T. 1 R. 4 W.</u>	<u>Sand &amp; Clay</u>	<u>72</u>	<u>135</u>
(distance) <u>2 1/2</u> miles <u>West</u> of <u>Taylor</u> (direction) (nearest Town)	<u>White Clay</u>	<u>6</u>	<u>141</u>
(3) Topography: <u>Hill</u>	<u>Sand</u>	<u>19</u>	<u>160</u>
(4) Purpose of Well: <u>Domestic</u>			
(Domestic Irrigation, Municipal, Industrial, Other)			


Information upon completion of well:

- (1) Diameter 2<sup>1</sup> inches.
- (2) Total Depth 160 feet.
- (3) Water Level 120 feet below top of ground.
- (4) Cased to No, Size ✓
- (5) Screen: Size 2<sup>1</sup>, Length 5
- (6) Were any formations sealed against pollution?  
 yes,  no.

If YES depth of formation \_\_\_\_\_

Why \_\_\_\_\_

Drillers Remarks: \_\_\_\_\_

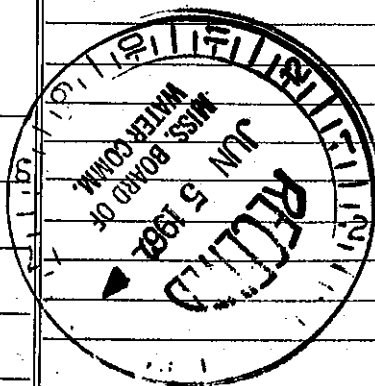

(Use Back Side)

Well No. \_\_\_\_\_

Retain this copy for your office files.