

L.A.F. MISSISSIPPI BOARD OF WATER COMMISSIONERS

J 22

9-24-62

WATER WELL DRILLERS LOG

Date: 9-24, 1962, Driller: Elliott Hdw Co County Lafayette
(Name)


(1) Owner of Land: Joe Martin
(Name)
Rt 4 Oxford
(Address)
 (2) Location: 1/4, SW 1/4, Sec. 17 T9S R4W
9 miles South W of Oxford
(distance) (direction) (Nearest Town)
 (3) Topography: Hilly
(Hilly) (Flat) (Level)
 (4) Purpose of Well: Domestic
(Domestic Irrigation Municipal, Industrial, Other)

Description & Color of Materials Sand, Clay, Red Clay, Shell, etc.	Thick- ness Feet	Depth Feet
<u>Red clay</u>	<u>19</u>	<u>19</u>
<u>sand-</u>	<u>30</u>	<u>49</u>
<u>gray clay</u>	<u>62</u>	<u>111</u>
<u>sand</u>	<u>23</u>	<u>134</u>

Information upon completion of well:

(1) Diameter 2" inches.
 (2) Total Depth 134 feet.
 (3) Water Level 96 feet below top of ground.
 (4) Cased to No, Size _____
 (5) Screen: Size 2", Length 6'
 (6) Were any formations sealed against pollution?
 _____ yes, no.

If YES depth of formation _____
 Why _____
 Drillers Remarks: _____

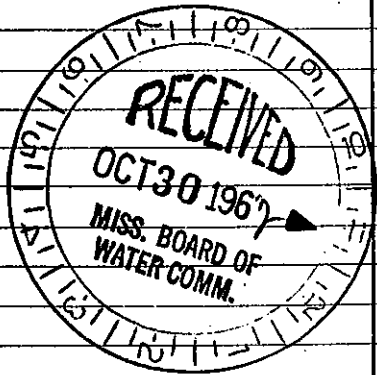

(Use Back Side)

Well No.