

LAF. MISSISSIPPI BOARD OF WATER COMMISSIONERS

J23

12-5-62 WATER WELL DRILLERS LOG

Date: 12-5, 1962, Driller: E. H. H. H. H. County: Leflore

(Name)

(1) Owner of Land: Robt. Williamson Jr
 (Name)
Oxford Pt 4
 (Address)

(2) Location: 30 9S R5W
7 miles West of Taylor
 (distance) (direction) (Nearest Town)

(3) Topography: Hilly
 (Hilly) (Flat) (Level)

(4) Purpose of Well: Domestic
 (Domestic Irrigation, Municipal, Industrial, Other)

Description & Color of Materials Sand, Clay, Red Clay, Shell, etc	Thick- ness Feet	Depth Feet
CLAY-Red	25	25
Sand+clay-	48	73
clay white	6	79
Sand-	6	85
clay-white-	22	107
Sand-hard Brown	43	150
Clay-white	10	160
Hard Brown sand	40	200

Information upon completion of well:

(1) Diameter 4 inches.

(2) Total Depth 200 feet.

(3) Water Level 160 feet below top of ground.

(4) Cased to No, Size ✓


(5) Screen: Size 2", Length 6'

(6) Were any formations sealed against pollution?
no yes, ✓ no.

If YES depth of formation _____

Why _____

Drillers Remarks: _____

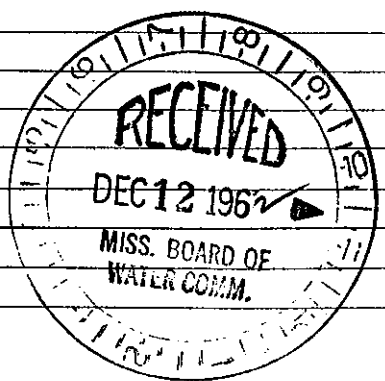

(Use Back Side)

Well No.

Mail this copy to Board of Water Commissioners 429 Miss. St. Jackson, Mis