

LAFAYETTE
 J 31
 4-68

MISSISSIPPI
 BOARD OF WATER COMMISSIONERS
 416 North State Street
 Jackson, Mississippi 39201

WATER WELL DRILLERS LOG

4-13 date well completed
 GB Elliott Hardware Lafayette county well located
 firm name


LANDOWNER: W.S. GRONER
 Pt 4
 O Ford, Miss (mailing address)

description of formations encountered	from	to
Red Clay	0	18
SAND & Clay	18	72
SAND-White Clay	72	90
		91

WELL LOCATION:
 sec 23 T 9 S N R 5 W E W
 10 miles S W of Oxford
 (distance) (direction) (nearest town)

WELL PURPOSE:
 (home, irrigation, municipal, industrial)

- WELL COMPLETION DATA:
- (1) diameter (inches) 4"
 - (2) total depth (feet) 90'
 - (3) static water level (feet) 47' below top of ground
 - (4) casing PVC 84' (material) (depth)
 - (size) if telescope see back.
 - (5) screen 6' (length) (depth to top)
 4" PVC (size) (material)
 - (6) pump 1/2 HP 10 (type power) (yield gpm)
 Electric
 - (7) electric log No (yes or no)
 (organization running log)
 - (8) how well bottom plugged Plug

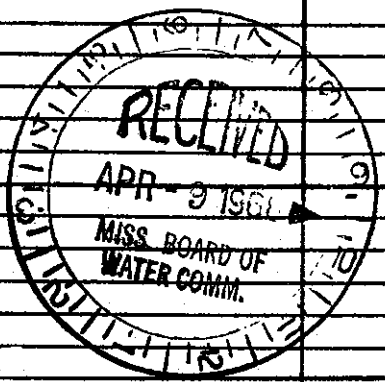

DRILLERS REMARKS:
 Good