

Lafayette
 J 34
 8-7-68

MISSISSIPPI
 BOARD OF WATER COMMISSIONERS
 416 North State Street
 Jackson, Mississippi 39201

WATER WELL DRILLERS LOG


Aug 7 1968 Robinson Bros Lafayette
 date well completed firm name county well located

LANDOWNER: Dick Latum	description of formations encountered	from	to
Taylor, Miss (mailing address)	Red clay + sand white sand	0	40 40 60

WELL LOCATION:
 sec. 13 T. 9 N R. 4 E
 4 1/2 miles NE of Taylor
 (distance) (direction) (nearest town)

WELL PURPOSE: Home
 (home, irrigation, municipal, industrial)

- WELL COMPLETION DATA:
- (1) diameter (inches) 4
 - (2) total depth (feet) 60
 - (3) static water level (feet) 36 below top of ground.
 - (4) casing Plastic, 55-
(material) (depth)
4 (size) If telescope see back.
 - (5) screen 55- 55-
(length) (depth to top)
4" gravel packed
(size) (material)
 - (6) pump 3/4 14
(HP) (yield gpm)
EVA 220
(type power)
 - (7) electric log no
(yes or no)
(organization running log)
 - (8) how well bottom plugged Capped

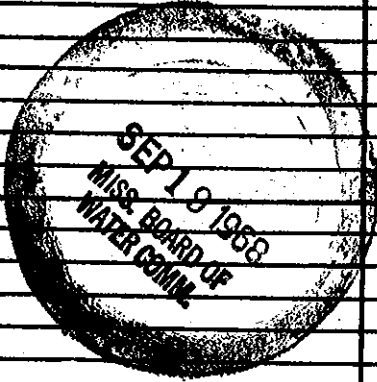

DRILLERS REMARKS: Plastic Water well