

State Well Report

Part 1

Mississippi Department of Environmental Quality
Office of Land and Water Resources
P.O. Box 10631
Jackson, MS 39289-0631
(601)961-5210
(601)354-6938 (fax)

For Office Use Only:

Aquifer: _____
Well #: J-20
L. S. Elevation: _____
E-log #: _____

County: Lafayette
Permit #: _____
Driller: Zeeper Drilling
Date drilling completed: _____

State Law requires that this report be prepared by the driller in detail and filed with the Department within 30 days of completion of drilling of the well.

Well Owner Information	Well Location
Owner Name: <u>P & L Hunting Club</u>	Latitude: _____ Longitude: _____
Mailing Address: <u>c/o Leo Calverne</u> <u>CR 82</u>	Method of Lat/Long (circle one): Conventional Survey, USGS quad, Hand-held GPS, Survey-grade GPS
<u>Batesville MS</u> City State Zip Code	<u>1/4 1/4 Sec 15 Twn 9S Rng 5W</u>
Telephone No. <u>(662) 563-2551</u>	Distance Direction Nearest Town <u>12 Miles SW of Oxford on</u> <u>Lafayette/PAWOLA Co Line</u>

Well Data

Purpose of Well (circle one) Home Industrial Public Supply Irrigation Fish Culture Other: DEER CAMP

Date well drilling started: 9-14-06 Date well drilling completed: 9-14-06

If flowing, method of flow regulation: Valve _____ Other (describe) _____

Static Water Level: 210 feet above or (below) (circle one) land surface Date measured: 9-15-06

Method of Measurement (circle one) steel tape electric tape air line other: _____

Hole depth: 241 ft Well depth: 241 ft Well grouted to a depth of 10 feet

Type of grout (circle one): Cement Bentonite Mix

Casing length: 221 feet Casing diameter: 4" inches Type of casing: PVC

Screen length: 20 feet Screen diameter: 4" inches Type of screen: PVC

Screen slot size: 1/16 inches Setting depth: From 221 feet to 241 feet

Type of completion (circle all applicable): Gravel packed Underreamed Telescoped Open hole Natural Development
Other (describe): _____

Top of lap pipe or reduction in casing: _____ feet. If telescoped or more than one screen, describe on back of page

Logs run (circle all applicable): No log run Electric Gamma Ray Density Sonic Neutron Other: _____

Name of organization running log(s): _____

I certify that the well was drilled, constructed, and completed in accordance with all applicable requirements of the Mississippi Department of Environmental Quality and/or the Mississippi Department of Health regulations and state laws.

Zeeper Drilling #0079
Print Name of Water Well Contractor and License No.

[Signature]
Signature of Water Well Contractor


RECEIVED
SEP 28 2006
BY: OLWR

J-70

If well telescopes please sketch below and show depths.

Ground Level

241
↑
↓

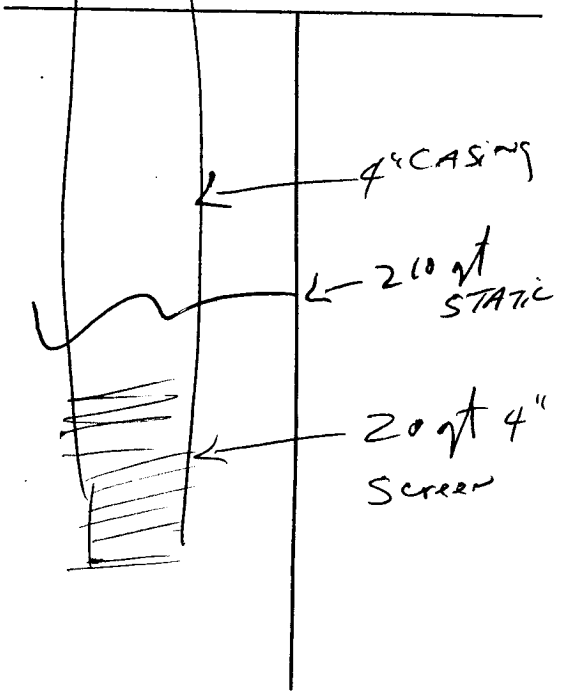

Description of Formations Encountered	From	To
TOP CLAY	0	10
Red Sand	10	80
Brown Sand	80	120
White Sand	120	150
Pink Clay	150	160
Brown Sand	160	200
pink White Sand	200	240

If more than one screen, show location of each on sketch

Sketch the property layout and include the following: 1) the well location; 2) any permanent structures on the property that may aid in locating the well; 3) any roads, power lines, or other items that may aid in locating the property and the well; 4) indicate direction.

Landowner Name: A & L Hunting Club

Signature of Water Well Contractor

RECEIVED
SEP 28 2006
BY: OLWR

STATE WELL REPORT

Part 2

Pump Installer's Completion Report
 Mississippi Department of Environmental Quality
 Office of Land and Water Resources
 P.O. Box 10631
 Jackson, MS 39289-0631
 (601)961-5210
 (601)354-6938 (fax)

County: Lafayette
 Permit #: _____
 Driller: Leeper Drilling
 Date completed: 9-15-06

For Office Use Only:

Aquifer: _____
 Well #: J-10
 Elevation: _____

This report should be prepared by the pump installer in detail and filed with the Department within 30 days of the installation of pump.

Well Owner Information	Well Location
Owner Name: <u>P + L Hunting Club</u>	Latitude: _____ Longitude: _____
Mailing Address: <u>c/o Lew Lawrence</u>	Method of Lat/Long (circle one): Conventional Survey,
<u>ca 82</u>	USGS quad, Hand-held GPS, Survey-grade GPS
<u>Bataavia MS</u>	_____ 1/4 _____ 1/4 Sec <u>15</u> Twn <u>9S</u> Rng <u>5W</u>
City State / Zip Code	Distance Direction Nearest Town
Telephone No. <u>(601) 563-2551</u>	<u>12 Miles SW of Oxford on Lafayette/Panola Co Line</u>

Pump Type Circle one	Power Type Circle one
Air Lift Jet <input type="radio"/> <u>Submersible</u> <input type="radio"/>	Diesel Engine Gasoline Engine Natural Gas
Bucket Piston <input type="radio"/> Turbine <input type="radio"/>	<u>Electric Motor</u> <input type="radio"/> Hand <input type="radio"/> Tractor PTO <input type="radio"/>
Centrifugal Rotary <input type="radio"/> Flowing Well <input type="radio"/>	Windmill Other (specify): _____
Other (specify): _____	Horse Power Rating of Motor: <u>1 HP</u>
Date Pump Installed: <u>9-15-06</u>	Setting Depth: <u>240</u> feet
Rated Pump Capacity: <u>10</u> Gallons Per Minute	Number of Stages: <u>14</u>

Pump Test Data	Method of Measuring Water Level Circle one
Date Well Tested: <u>9-15-06</u>	<u>Air Line</u> <input type="radio"/> Electric Measuring Line <input type="radio"/> Steel Tape <input type="radio"/>
Static Water Level (A): <u>210</u> Feet <u>Below</u> Land Surface	Other (specify): _____
Pumping Water Level (B): _____ Feet Below Land Surface	For flowing well, measured shut in head: _____ feet
Drawdown [(B) - (A)]: _____ Feet Below Land Surface	Well yielded _____ GPM with a drawdown of _____ feet after _____ hours of pumping
Test Pumping Rate: _____ Gallons Per Minute	
Duration of Pump Test (minimum 4 hours): _____ hours	

I HEREBY CERTIFY that the above statements are true to the best of my knowledge.

Leeper Drilling # 0079
 Print Name of Pump Installer and License No. (if applicable)

[Signature]
 Signature of Pump Installer

RECEIVED

SEP 28 2006

BY: OLWR