

MISSISSIPPI BOARD OF WATER COMMISSIONERS
LAFAYETTE

WATER WELL DRILLERS LOG


K
3-3-63

Date: Nov 3, 1963, Driller: Edward Clark County Union
 (Name)

		Description & Color of Materials Sand, Clay, Red Clay, Shell, etc.	Thick- ness Feet	Depth Feet
(1) Owner of Land: <u>Alvin Smith</u> (Name)		<u>Sand</u>	<u>90</u>	<u>90</u>
<u>Oxford Miss</u> (Address)		<u>Blue mud</u>	<u>170</u>	<u>90</u>
		<u>Yellow sand</u>	<u>13</u>	<u>170</u>
(2) Location: <u>1/4</u> , <u>1/4</u> , Sec. <u>T</u> <u>R</u>				
<u>6</u> miles <u>South</u> of <u>Oxford</u> (distance) (direction) (Nearest Town)				
(3) Topography: <u>Hilly</u> (Hilly) (Flat) (Level)				
(4) Purpose of Well: <u>Home use</u> (Domestic Irrigation Municipal, Industrial, Other)				

Information upon completion of well:

- (1) Diameter 4 inches.
 - (2) Total Depth 287 feet.
 - (3) Water Level 50 feet below top of ground.
 - (4) Cased to 108, Size 4
 - (5) Screen: Size 2 in pipe, Length 200 ft
 - (6) Were any formations sealed against pollution?
 yes, no.
- If YES depth of formation _____
 Why Sand
 Drillers Remarks: OK

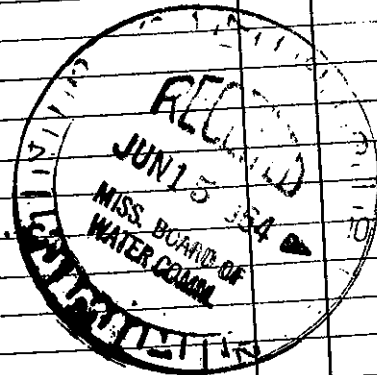

Well No.

(Use Back Side)

Mail this copy to Board of Water Commissioners 429 Miss. St. Jackson, Miss