

MISSISSIPPI BOARD OF WATER COMMISSIONERS

LAF.
OK 8
6-27-64

WATER WELL DRILLERS LOG


Date: June 27, 1964, Driller: Elliott Hdw. Co. Id.
(Name)

	Description & Color of Materials Sand, Clay, Red Clay, Shell, etc.	Thick- ness Feet	Depth Feet
(1) Owner of Land: <u>Woodrow Lee</u> (Name)	<u>Sand</u>	<u>60</u>	<u>60</u>
<u>Alford, Miss</u> (Address)	<u>Clay</u>	<u>2</u>	<u>62</u>
(2) Location: <u>1/4, 1/4, Sec 24 T9 R3</u> <u>3</u> miles <u>East</u> of <u>Alford</u> (distance) (direction) (Nearest Town)	<u>Sand</u>	<u>62</u>	<u>40</u>
(3) Topography: <u>Hilly</u> (Hilly) (Flat) (Level)	<u>Clay</u>	<u>102</u>	<u>112</u>
(4) Purpose of Well: <u>Domestic</u> (Domestic Irrigation Municipal, Industrial, Other)	<u>Sand</u>	<u>103</u>	<u>9</u>

Information upon completion of well:

- (1) Diameter 2 inches.
- (2) Total Depth 112 feet.
- (3) Water Level 92 feet below top of ground.
- (4) Cased to _____, Size _____.
- (5) Screen: Size 2 in, Length 5 ft.
- (6) Were any formations sealed against pollution?
_____ yes, no.

If YES depth of formation _____
Why _____
Drillers Remarks: _____

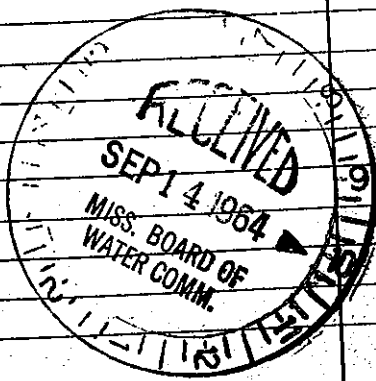

Well No. _____

(Use Back Side)

Retain this copy for your office files.