

LAF.
K9

MISSISSIPPI BOARD OF WATER COMMISSIONERS

7-27-60

WATER WELL DRILLERS LOG


K 300

Date: 7/27, 19 60, Driller: Elliott Hdwe. Co. County Lafayette

(Name)

W.P.
 (1) Owner of Land: Bill Bungardner
 (Name)
RFD # 4 - Oxford, Miss.
 (Address)
 (2) Location: 39 1/4, 3 1/4, Sec 39 T9R3
11 miles South of Oxford
 (distance) (direction) (Nearest Town)
 (3) Topography: Flat Bottom
 (Hilly) (Flat) (Level)
 (4) Purpose of Well: Domestic
 (Domestic Irrigation
 Municipal, Industrial, Other)

| Description & Color of Materials Sand, Clay, Red Clay, Shell, etc. | Thick- ness Feet | Depth Feet |
|---|------------------------|---------------|
| Clay | 20' | |
| Blue Clay or mud | 150' | 170' |
| Fine dirty sand | 35' | 205' |
| Blue clay or mud | 185' | 390' |
| Fine gray sand | 30' | 420' |
| Pretty good sand | 35' | 455' |
| Blue mud underneath | | 464' |

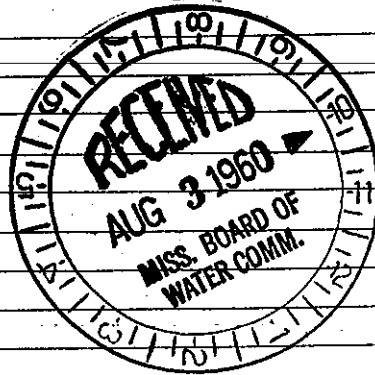

Information upon completion of well:

(1) Diameter 4" inches.

(2) Total Depth 464' feet.

(3) Water Level 15' feet below top of ground.

(4) Cased to _____, Size _____

(5) Screen: Size 2", Length 20'

(6) Were any formations sealed against pollution?
 _____ yes, X no.

If YES depth of formation _____

Why _____

Drillers Remarks: _____

Well No.
K300

(Use Back Side)