	<b>State We</b>	ell Report	
County: <u>La fayette</u> Permit #:		riller's Log	For Office Use Only
	Mississippi Department	of Environmental Quality	Aquifer: 42
Permit #:		d Water Resources	Well #.
Driller: <u>Narl, TT</u>	1	ox 10631 S 39289-0631	L. S. Elevation:
Date drilling completed: 8-7-07	1 · · · · ·	61-5210	L. S. Elevation:
	(601)354-	-6938 (fax)	E-log #:
State Law requires that this repo	et he neensed by the lices	ree holder oeroonsible for i	the work and filed with (
Department at the above addres	s within 30 days of comple	etion of drilling of the well	or borehole.
Information on Well Owner Well o		Well or Bo	rehole Location
<b>N T</b>	owner if borehole is not for a water well)		" Longitude: \$9 . 27 ,
Owner Name Sauid w	licms		
Mailing Address:		Method of Lat/Long (circle or	e): Conventional Survey,
······································	·	USGS quad, Hand-held	GPS, Survey-grade GPS
		SW 1/ 52 1/ Sec 51	
Orford MS City Sta		7 / 7 / / Sec_ J	
City Sta	te Zip Code	Distance Direction	Nearest Town
Telephone No. (727 458-6	820	<u>3</u> Miles <u>SE</u>	of Oxford
Location of the source of any surface wat Method of dosing and volume of Chlorin Logs run (circle all applicable): No log ru	er used for drilling:		
Location of the source of any surface wat Method of dosing and volume of Chlorin Logs run (circle all applicable): No log ru Name of organization running log(s): Purpose of borehole (check one): Water W	er used for drilling: e used in drilling and develop Electric Ramma Ray /ell X Geotechnical/Geolog	N/4       pment:	Other:
Location of the source of any surface wat Method of dosing and volume of Chlorin Logs run (circle all applicable): No log ru Name of organization running log(s): Purpose of borehole (check one): Water W Seismic	er used for drilling: e used in drilling and develop n Electric Ramma Ray /ell X Geotechnical/Geolog SurveyOther ( <i>describe</i> )	N/4       pment:	Other: Source Heat Pump
Location of the source of any surface wat Method of dosing and volume of Chlorin Logs run (circle all applicable): No log ru Name of organization running log(s): Purpose of borehole (check one): Water W Seismic If drilling is not related	er used for drilling: e used in drilling and develop n Electric Ramma Ray /ell X Geotechnical/Geolog Survey Other (describe) to water well construction,	J/A         pensity       Sonic         Neutron       Sonic         cical Investigation       Ground         skip the remainder of this block	Other: Source Heat Pump
Location of the source of any surface wat Method of dosing and volume of Chlorin Logs run (circle all applicable): No log ru Name of organization running log(s): Purpose of borehole (check one): Water W Seismic If drilling is not related Purpose of Well (check one): Home X I	er used for drilling: e used in drilling and develop n Electric Ramma Ray Vell X Geotechnical/Geolog SurveyOther (describe) I to water well construction, ndustrial Public Supply	J/A         pment:         Density         Sonic         Neutron         cical Investigation         Ground         skip the remainder of this blog         Irrigation         Fish Culture	Other:
Location of the source of any surface wat Method of dosing and volume of Chlorin Logs run (circle all applicable): No log ru Name of organization running log(s): Purpose of borehole (check one): Water W Seismic If drilling is not related	er used for drilling: e used in drilling and develop n Electric Ramma Ray Vell X Geotechnical/Geolog SurveyOther (describe) I to water well construction, ndustrial Public Supply	J/A         pment:         Density         Sonic         Neutron         cical Investigation         Ground         skip the remainder of this blog         Irrigation         Fish Culture	Other:
Location of the source of any surface wat Method of dosing and volume of Chlorin Logs run (circle all applicable): No log ru Name of organization running log(s): Purpose of borehole (check one): Water W Seismic If drilling is not related Purpose of Well (check one): Home X I If a flowing well, method of flow regulation	er used for drilling: e used in drilling and develop n Yell X Geotechnical/Geolog SurveyOther ( <i>describe</i> ) <i>Ito water well construction</i> , ndustrialPublic Supply on: ValveOther	N/A         pment:         Density Sonic Neutron         gical Investigation         Ground         skip the remainder of this black         Irrigation         Fish Culture         er (describe)	Other:
Location of the source of any surface wat Method of dosing and volume of Chlorin Logs run (circle all applicable): No log ru Name of organization running log(s): Purpose of borehole (check one): Water W Seismic If drilling is not related Purpose of Well (check one): Home X I If a flowing well, method of flow regulation Static Water Level: 70 feet all	er used for drilling: e used in drilling and develop n Vell Geotechnical/Geolog SurveyOther ( <i>describe</i> ) <i>Ito water well construction</i> , ndustrial Public Supply on: Valve Other pove or below (circle one) land	J/A         pment:         Density Sonic Neutron         gical Investigation Ground         skip the remainder of this blog	Other:
Location of the source of any surface wat Method of dosing and volume of Chlorin Logs run (circle all applicable): No log ru Name of organization running log(s): Purpose of borehole (check one): Water W Seismic If drilling is not related Purpose of Well (check one): Home X I If a flowing well, method of flow regulation Static Water Level: 70 feet all Method of Measurement (circle one) states	er used for drilling: e used in drilling and develop n Electric Ramma Ray /ell X Geotechnical/Geolog SurveyOther ( <i>describe</i> ) / to water well construction, ndustrial Public Supply on: ValveOther powe or below (circle one) lan eel tape electric tape	JA         pment:         Density Sonic Neutron         gical Investigation         gical Investigation         Ground         skip the remainder of this black	Other:
Location of the source of any surface wat Method of dosing and volume of Chlorin Logs run (circle all applicable): No log ru Name of organization running log(s): Purpose of borehole (check one): Water W Seismic If drilling is not related Purpose of Well (check one): Home X I If a flowing well, method of flow regulation Static Water Level: 70 feet al Method of Measurement (circle one) st Well depth: 320 Well grouted to a de	er used for drilling: e used in drilling and develop n Vell_X Geotechnical/Geolog SurveyOther ( <i>describe</i> ) <i>Ito water well construction</i> , ndustrialPublic Supply on: ValveOther powe or below (circle one) lance eel tape electric tape pth offeet Type of	J/A         pment:         Density Sonic Neutron         gical Investigation         gical Investigation         Ground         skip the remainder of this blog         Irrigation         Fish Culture         er (describe)         et air line         other:         air line         other:         f grout (circle one): Neat Ceme	Other: Source Heat Pump cet Other:  ent Bentonite Mix
Location of the source of any surface wat Method of dosing and volume of Chlorin Logs run (circle all applicable): No log ru Name of organization running log(s): Purpose of borehole (check one): Water W Seismic If drilling is not related Purpose of Well (check one): Home X I If a flowing well, method of flow regulation Static Water Level: 70 feet al Method of Measurement (circle one) st Well depth: 320 Well grouted to a de	er used for drilling: e used in drilling and develop n Vell_X Geotechnical/Geolog SurveyOther ( <i>describe</i> ) <i>Ito water well construction</i> , ndustrialPublic Supply on: ValveOther powe or below (circle one) lance eel tape electric tape pth offeet Type of	J/A         pment:         Density Sonic Neutron         gical Investigation         gical Investigation         Ground         skip the remainder of this blog         Irrigation         Fish Culture         er (describe)         et air line         other:         air line         other:         f grout (circle one): Neat Ceme	Other: Source Heat Pump ck Other: ent Bentonite Mix
Location of the source of any surface wat Method of dosing and volume of Chlorin Logs run (circle all applicable): No log ru Name of organization running log(s): Purpose of borehole (check one): Water W Seismic If drilling is not related Purpose of Well (check one): Home X I If a flowing well, method of flow regulation Static Water Level: TO feet all Method of Measurement (circle one) st Well depth: SZO Well grouted to a de Casing length: SIO feet Casin	er used for drilling: e used in drilling and develop n Vell_X Geotechnical/Geolog SurveyOther ( <i>describe</i> ) <i>to water_well construction</i> , ndustrialPublic Supply on: ValveOther cove or below (circle one) lan eel tape electric tape pth offeet Type of ng diameter:	J/A         pensity       Sonic         Density       Sonic         Neutron       Ground         gical Investigation       Ground         skip the remainder of this blog	Other: Source Heat Pump sck Other: ent Bentonite Mix Bentonite Mix
Location of the source of any surface wat Method of dosing and volume of Chlorin Logs run (circle all applicable): No log ru Name of organization running log(s): Purpose of borehole (check one): Water W Seismic If drilling is not related Purpose of Well (check one): Home X I If a flowing well, method of flow regulation Static Water Level: 70 feet all Method of Measurement (circle one) st Well depth: 320 Well grouted to a de Casing length: 310 feet Casin Screen length: 10 feet Scree	er used for drilling: e used in drilling and develop n Vell_X Geotechnical/Geolog SurveyOther ( <i>describe</i> ) <i>to water well construction</i> , ndustrialPublic Supply on: ValveOther cove or below (circle one) lan eel tape electric tape pth offeet Type of ng diameter: en diameter:	JA         pment:         Density Sonic Neutron         gical Investigation Ground         skip the remainder of this blog	Other: Source Heat Pump cot Other: ent Bentonite Mix Cother: Ent Bentonite Mix Cother:
Location of the source of any surface wat Method of dosing and volume of Chlorin Logs run (circle all applicable): No log ru Name of organization running log(s): Purpose of borehole (check one): Water W Seismic If drilling is not related Purpose of Well (check one): Home X I If a flowing well, method of flow regulation Static Water Level: O feet all Method of Measurement (circle one) st Well depth: XO feet Casin Casing length: XO feet Casin	er used for drilling: e used in drilling and develop n Vell_X Geotechnical/Geolog SurveyOther ( <i>describe</i> ) <i>to water well construction</i> , ndustrialPublic Supply on: ValveOther cove or below (circle one) lan eel tape electric tape pth offeet Type of ng diameter: en diameter:	JA         pment:         Density Sonic Neutron         gical Investigation Ground         skip the remainder of this blog	Other: Source Heat Pump cot Other: ent Bentonite Mix Cother: Ent Bentonite Mix Cother:
Location of the source of any surface wat Method of dosing and volume of Chlorin Logs run (circle all applicable): No log ru Name of organization running log(s): Purpose of borehole (check one): Water W Seismic If drilling is not related Purpose of Well (check one): Home X I If a flowing well, method of flow regulation Static Water Level: 70 feet all Method of Measurement (circle one) st Well depth: 320 Well grouted to a de Casing length: 310 feet Casin Screen length: 10 feet Scree Screen slot size: 410 inches	er used for drilling: e used in drilling and develop nElectricanma Ray Vell_X Geotechnical/Geolog SurveyOther (describe) Ito water well construction, ndustrialPublic Supply on: ValveOther cove or below (circle one) lan eel tape electric tape opth offeet Type of ng diameter: Setting depth: From	J/A         pment:         Density Sonic Neutron         gical Investigation         Fish Culture         er (describe)         er (describe)         air line         other:         air line         other:         f grout (circle one): Neat Ceme         inches       Type of casing:         inches       Type of screen:         310       feet to	Other:   Source Heat Pump   Source Heat Pump   cother:
Location of the source of any surface wat Method of dosing and volume of Chlorin Logs run (circle all applicable): No log ru Name of organization running log(s): Purpose of borehole (check one): Water W Seismic If drilling is not related Purpose of Well (check one): Home X I If a flowing well, method of flow regulation Static Water Level: 70 feet all Method of Measurement (circle one) st Well depth: 320 Well grouted to a de Casing length: 310 feet Casin Screen length: 10 feet Scree	er used for drilling: e used in drilling and develop n	J/4         pment:         Density Sonic Neutron         gical Investigation         gical Investigation         ground         skip the remainder of this blog	Other:   Source Heat Pump   Source Heat Pump   ck
Location of the source of any surface wat Method of dosing and volume of Chlorin Logs run (circle all applicable): No log ru Name of organization running log(s): Purpose of borehole (check one): Water W Seismic If drilling is not related Purpose of Well (check one): Home X I If a flowing well, method of flow regulation Static Water Level: 70 feet all Method of Measurement (circle one) st Well depth: 320 Well grouted to a de Casing length: 310 feet Casin Screen length: 10 feet Scree Screen slot size: 410 inches	er used for drilling: e used in drilling and develop n Electric Ramma Ray Vell X Geotechnical/Geolog Survey Other (describe) Industrial Public Supply on: Valve Other cove or below (circle one) lan eel tape electric tape opth offeet Type of ng diameter: Setting depth: From Gravel packed Underrea Other (describe):	J/A         penent:         Density Sonic Neutron         gical Investigation         Ground         skip the remainder of this blog         Irrigation         Fish Culture         er (describe)         er (describe)         air line         other:         air line         other:         inches         Type of casing:         inches         Type of screen:         310         feet to         3         amed         Telescoped         Open I	Other:


.

AUG 2 9 2007 BY: OLWR

e <u>sketch below only required for</u> <u>water wells</u>	<u>Description of formations encountered must be provided for all</u> wells and boreholes, unless specifically exempted by regulations			
vell telescopes, show depths on sketch. Ground Level	Description of Formations Encountered	From (depth)	To (depth	
	Sand	Ground Level	7	
	Rock	7	8	
	Clay	8	140	
	Rock's 94/112			
	Clay/sand	140	175	
	RiceK	175	176	
	clay/ignite/sand	174	220	
	clay	220	240	
	clay/sand	240	290	
	Rock	290	291	
	sand	291	32	
	Sand/clay/lignylo		340	
	Sand	340	360	
	Kak	360	361	
	end/clay	341	380	
	······································	<u> </u>		
		·····	+	
		1		
		<u> </u>	-	
]		1	1	
			1	
		1	1	

If more than one screen, show location of each on sketch

. •

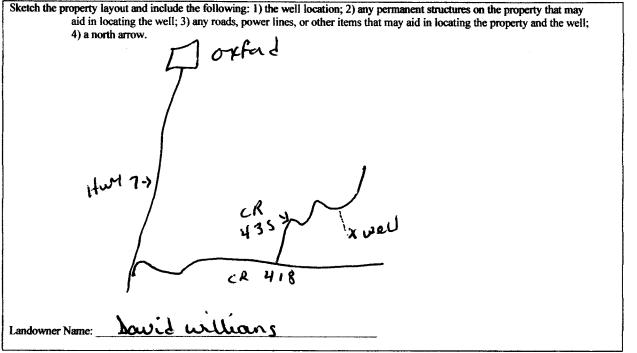

Form: OLWR-SWR-1A

I certify that the well/borehole was drilled, constructed, and completed in accordance with all applicable requirements of the Mississippi Department of Environmental Quality and the Mississippi Department of Health regulations, if applicable, and state

Date

laws. KATL. Ft 0-002 8-8-07

bl M

Print Name of Responsible Licensee and License No.

Signature of Licensee

RECEIVED AUG 2 9 2007 BY: OLWR

KUL