

LAFAYETTE MISSISSIPPI BOARD OF WATER COMMISSIONERS

WATER WELL DRILLERS LOG

**CODED**

Date: 6/12, 1963, Driller: ELLIOTT HARDWARE COMPANY, Lafayette County, MISSISSIPPI

(1) Owner of Land: Guy Barlow  
 (Name)  
Tuba Road  
 (Address)  
 (2) Location: 1/4 1/4, Sec 21 T24N  
1 miles East, of Oxford  
 (distance) (direction) (Nearest Town)  
 (3) Topography: Hilly  
 (Hilly) (Flat) (Level)  
 (4) Purpose of Well: DOMESTIC  
 (Domestic Irrigation, Municipal, Industrial, Other)


Description & Color of Materials Sand, Clay, Red Clay, Shell, etc.	Thick- ness Feet	Depth Feet
<u>Blue Clay</u>	<u>42</u>	<u>42</u>
<u>Rock</u>	<u>1</u>	<u>43</u>
<u>Blue Clay + Shale</u>	<u>200</u>	<u>243</u>
<u>FINE Gray Sand</u>	<u>25</u>	<u>268</u>

Information upon completion of well:

- (1) Diameter 4 inches.  
 (2) Total Depth 268 feet.  
 (3) Water Level 40 feet below top of ground.  
 (4) Cased to 168, Size 4.  
 (5) Screen: Size No, Length —.  
 (6) Were any formations sealed against pollution?  
 \_\_\_\_\_ yes, \_\_\_\_\_ no.

If YES depth of formation \_\_\_\_\_  
 Why \_\_\_\_\_  
 Drillers Remarks: \_\_\_\_\_

**CODED**

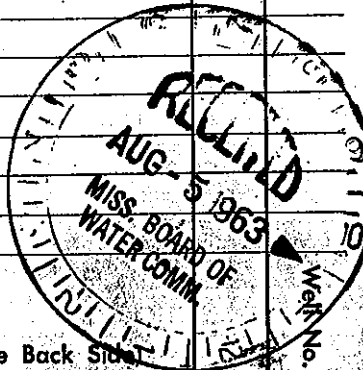

(Use Back Side)

Mail this copy to Board of Water Commissioners 429 Miss. St. Jackson, Miss.