

LAF.  
OL7  
5-18-63


MISSISSIPPI BOARD OF WATER COMMISSIONERS

WATER WELL DRILLERS LOG

ELLIOTT HARDWARE COMPANY

Date: May 18, 1963, Driller: OXFORD, MISSISSIPPI

(Name)

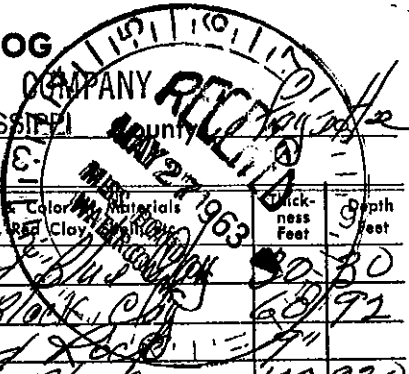

(1) Owner of Land: Jay Barkel  
(Name)  
RFD # 5 - Oxford  
(Address)

(2) Location: 1/4, NE 1/4, Sec 23 T 25 R 24  
9 miles East of OXFORD  
(distance) (direction) (Nearest Town)

(3) Topography: Flat  
(Hilly) (Flat) (Level)

(4) Purpose of Well: Domestic  
(Domestic Irrigation  
Municipal, Industrial, Other)

Description & Color	Materials	Thick-ness Feet	Depth Feet
<u>Hard Blue Clay</u>	<u>Hard Blue Clay</u>	<u>30-30</u>	<u>30</u>
<u>Soft Black Clay</u>	<u>Soft Black Clay</u>	<u>65-92</u>	<u>92</u>
<u>Hard Rock</u>	<u>Hard Rock</u>	<u>1-17"</u>	<u>17</u>
<u>Soft Black</u>	<u>Soft Black</u>	<u>138-230</u>	<u>230</u>
<u>VINE GRY Sand</u>	<u>VINE GRY Sand</u>	<u>45-275</u>	<u>275</u>

Information upon completion of well:

(1) Diameter 4 inches.

(2) Total Depth 275 feet.

(3) Water Level 60 feet below top of ground.

(4) Cased to 126, Size 4"

(5) Screen: Size No, Length No

(6) Were any formations sealed against pollution?  
\_\_\_\_\_ yes, \_\_\_\_\_ no.

If YES depth of formation \_\_\_\_\_

Why \_\_\_\_\_

Drillers Remarks: \_\_\_\_\_

Well No.

(Use Back Side)

his copy to Board of Water Commissioners 429 Miss. St. Jackson, Miss.