

LAF.
L8
5-1-61

MISSISSIPPI BOARD OF WATER COMMISSIONERS

WATER WELL DRILLERS LOG

2 300

Date: 5-1, 1961, Driller: ELLIOTT HARDWARE COMPANY, LaFayette
OXFORD, MISSISSIPPI
(Name)


(1) Owner of Land: Shirley Gardner
(Name)
Oxford, Miss - P.P.D.
(Address)
(2) Location: 1/4, 1/4, Sec 2 T25R24
8 miles East of Oxford
(distance) (direction) (Nearest Town)
(3) Topography: Hilly
(Hilly) (Flat) (Level)
(4) Purpose of Well: Domestic
(Domestic Irrigation
Municipal, Industrial, Other)

Description & Color of Materials Sand, Clay, Red Clay, Shell, etc.	Thick- ness Feet	Depth Feet
<u>White Clay</u>	<u>35</u>	<u>35</u>
<u>Blue Clay</u>	<u>51</u>	<u>86</u>
<u>Brown Mica Sand</u>	<u>32</u>	<u>118</u>
<u>Blue, Brown Clay</u>	<u>80</u>	<u>198</u>
<u>Fine Mica Sand</u>	<u>22</u>	<u>220</u>

Information upon completion of well:

(1) Diameter 2 inches.
(2) Total Depth 220 feet.
(3) Water Level 80 feet below top of ground.
(4) Cased to 175, Size 4"
(5) Screen: Size 0, Length _____
(6) Were any formations sealed against pollution?
_____ yes, _____ no.

If YES depth of formation _____
Why _____
Drillers Remarks: _____

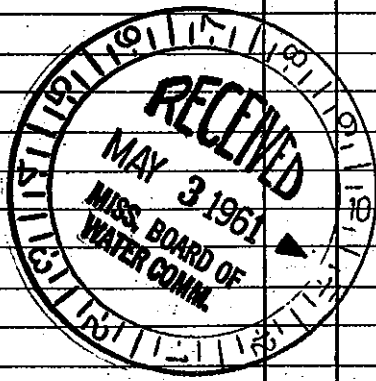

Well No.

(Use Back Side)

Retain this copy for your office files.