

LAF.
69

MISSISSIPPI BOARD OF WATER COMMISSIONERS


8-20-65 WATER WELL DRILLERS LOG

Date: 8-20, 1965, Driller: Elliott Howard, County: La Fayette
(Name)

(1) Owner of Land:	Description & Color of Material Sand, Clay, Red Clay, Shell, etc.	Thick- ness Feet	Depth Feet
JA Centrell Oxford, Miss (Name) (Address)	Blue Clay	70	70
	Rock	20	90
(2) Location: 1/4, 1/4, Sec. 31 T16N R10W	White Clay	42	132
8 miles East of Oxford (distance) (direction) (Nearest Town)	Black Clay	70	212
(3) Topography: (Hilly) (Flat) (Level)	Blue Clay	68	290
(4) Purpose of Well: Domestic (Domestic Irrigation Municipal, Industrial, Other)	Mixture-Clay Sand	60	350

Information upon completion of well:

- (1) Diameter 4 inches.
- (2) Total Depth 350 feet.
- (3) Water level 70 feet below top of ground.
- (4) Cased to 250, Size 4
- (5) Screen: Size NONE, Length _____
- (6) Were any formations sealed against pollution?
_____ yes, _____ no.
- If YES depth of formation _____
- Why _____
- Drillers Remarks: _____

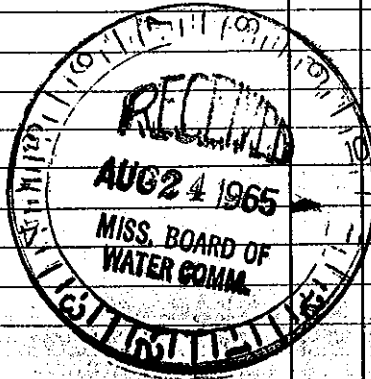

Well No

(Use Back Side)

Mail this copy to Board of Water Commissioners 429 Miss. St. Jackson, Miss