

La Fayette
 L10
 3-67

MISSISSIPPI
 BOARD OF WATER COMMISSIONERS
 416 North State Street
 Jackson, Mississippi 39201

WATER WELL DRILLERS LOG

Mar. 20 19 67 Ellhart Hardware Co La Fayette
 date well completed firm name county well located


LANDOWNER: Mr + Mrs
Travis Fooshee
Oxford, Miss. RT 4
 (mailing address)

description of formations encountered	from	to
<u>Brown Sand</u>	<u>0'</u>	<u>48'</u>
<u>Green Clay</u>	<u>48'</u>	<u>96'</u>
<u>Hard Clay - Black Sand</u>	<u>96'</u>	<u>281'</u>
	<u>281'</u>	<u>201'</u>

WELL LOCATION:
 sec. 9 T. 9 S. R. 2 E. W.
8 miles East of Oxford
 (distance) (direction) (nearest town)

WELL PURPOSE: HOME
 (home, irrigation, municipal, industrial)

- WELL COMPLETION DATA:
- (1) diameter (inches) 4"
 - (2) total depth (feet) 201
 - (3) static water level (feet) 20' below top of ground.
 - (4) casing Steel, 132',
 (material) (depth)
4" If telescope see back.
 (size)
 - (5) screen NONE,
 (length) (depth to top)
 (size) (material)
 - (6) pump 3/4 4
 (HP) (yield gpm)
Electric
 (type power)
 - (7) electric log No
 (yes or no)
 (organization running log)
 - (8) how well bottom plugged

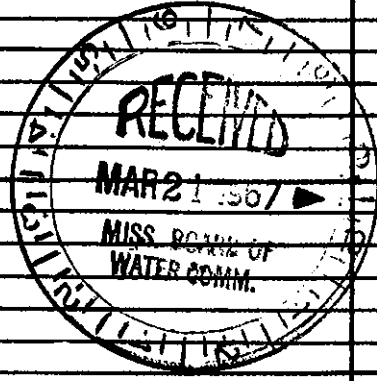

DRILLERS REMARKS: