

MISSISSIPPI BOARD OF WATER COMMISSIONERS

LAF.
 OM6
 10-25-62

WATER WELL DRILLERS LOG


Date: 10/25, 1962, Driller: Elliott Haden County: Lafayette
 (Name)

(1) Owner of Land:	Description & Color of Materials Sand, Clay, Red Clay, Shell, etc.	Thick- ness Feet	Depth Feet
<u>L. E. Shorter</u> (Name) <u>Oxford, Miss - Tule St. Rt.</u> (Address)	<u>Red Clay</u>	<u>17</u>	<u>17</u>
	<u>Blue Mud & Clay</u>	<u>13</u>	<u>30</u>
	<u>Clay & Sand Strips</u>	<u>30</u>	<u>160</u>
(2) Location: <u>1/4</u> , <u>1/4</u> , Sec <u>28</u> T <u>25</u> R <u>12</u> W	<u>Blue Mica Sand</u>	<u>45</u>	<u>205</u>
<u>9</u> miles <u>East</u> of <u>Oxford</u> (distance) (direction) (Nearest Town)	<u>Blue Clay</u>	<u>10</u>	<u>215</u>
(3) Topography: <u>Hilly</u> (Hilly) (Flat) (Level)			
(4) Purpose of Well: <u>Domestic</u> (Domestic Irrigation Municipal, Industrial, Other)			

Information upon completion of well:

- (1) Diameter 4" inches.
- (2) Total Depth 215 feet.
- (3) Water Level 20' feet below top of ground.
- (4) Cased to 147', Size 4"
- (5) Screen: Size No, Length ✓
- (6) Were any formations sealed against pollution?
 yes, no.

If YES depth of formation 130'
 Why Blue Mud - To avoid
 Drillers Remarks: a taste in
the water

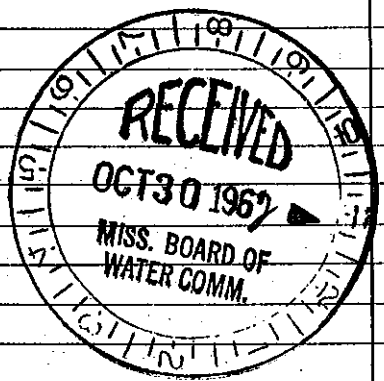

Well No.

(Use Back Side)

Retain this copy for your office files.