

WATER WELL DRILLERS LOG

M 2000
11-6-63

Date: Nov 6, 1963, Driller: Pat Donough County Worth
(Name)

(1) Owner of Land:	Description & Color of Materials Sand, Clay, Red Clay, Shell, etc.	Thick- ness Feet	Depth Feet
<u>F. H. Ballou</u> (Name)	<u>Red clay</u>	<u>24</u>	<u>20</u>
<u>axford miss</u> (Address)	<u>Blue</u>	<u>90</u>	<u>40</u>
(2) Location: <u>1/4</u> , <u>1/4</u> , Sec. <u>22</u> T. <u>21</u> N.	<u>Blue marl</u>	<u>405</u>	<u>100</u>
<u>18</u> miles <u>East</u> of <u>axford</u> (distance) (direction) (Nearest Town)			
(3) Topography: <u>X</u> (Hilly) <u></u> (Flat) <u></u> (Level)			
(4) Purpose of Well: <u>Home use</u> (Domestic Irrigation Municipal, Industrial, Other)			


Information upon completion of well:

- (1) Diameter 6 inches.
- (2) Total Depth 575 feet.
- (3) Water Level 80 feet below top of ground.
- (4) Cased to 108, Size 4.
- (5) Screen: Size none, Length _____.
- (6) Were any formations sealed against pollution?
_____ yes, _____ no.

If YES depth of formation _____

Why _____

Drillers Remarks: open

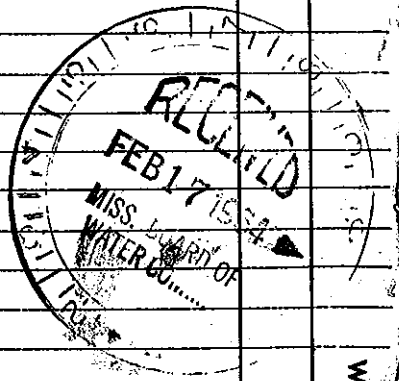

Well No. _____

(Use Back Side)

Retain this copy for your office files.