

LAF.

MISSISSIPPI BOARD OF WATER COMMISSIONERS

N13

WATER WELL DRILLERS LOG

12-2-62

Date: 12-2, 1962, Driller: Ellen H. Huddle County DeFayette

(Name)

(1) Owner of Land: Jack Pen Crow
(Name)
Water Valley, Miss - RT 4
(Address)

Description & Color of Materials
Sand, Clay, Red Clay, Shell, etc.

Thick-
ness
Feet

Depth
Feet

Red Clay
White Clay
Sand

18 18
14 32
28 60

(2) Location: 1/4, 1/4, Sec T10S4W
9 miles North, of Water Valley
(distance) (direction) (Nearest Town)

(3) Topography: Hilly
(Hilly) (Flat) (Level)

(4) Purpose of Well: Domestic
(Domestic Irrigation
Municipal, Industrial, Other)


Information upon completion of well:

(1) Diameter 2' inches.
(2) Total Depth 60' feet.
(3) Water Level 45 feet below top of ground.
(4) Cased to NO, Size ✓
(5) Screen: Size 2", Length 5'
(6) Were any formations sealed against pollution?
_____ yes, _____ no.

If YES depth of formation _____

Why _____

Drillers Remarks: _____

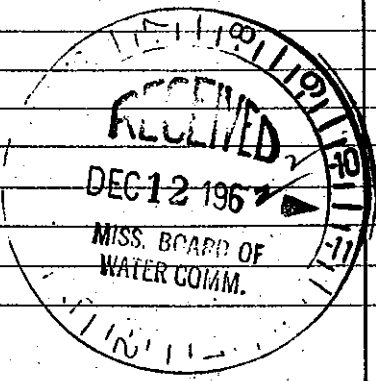

Well No.

(Use Back Side)

Retain this copy for your office files.