


LAFAY,
 N 14
 10-20-65

MISSISSIPPI BOARD OF WATER COMMISSIONERS

WATER WELL DRILLERS LOG

Date: 10-20, 1965, Driller: Jimmy Peterson County: [Redacted]
 (Name)

(1) Owner of Land:	Description & Color of Materials Sand, Clay, Red Clay, Shell, etc.	Thick- ness Feet	Depth Feet
<u>Mr Frank Cooper</u> (Name)	<u>Clay</u>	<u>0</u>	<u>30</u>
<u>Gayles Miss</u> (Address)	<u>Sand & Clay</u>	<u>30</u>	<u>40</u>
(2) Location: <u>1/4, 1/4, Sec. 3 T/DR 5</u>	<u>Sand</u>	<u>40</u>	<u>60</u>
<u>3</u> miles <u>S-W</u> , of <u>Gayles</u> (distance) (direction) (Nearest Town)			
(3) Topography: <input checked="" type="checkbox"/> (Hilly) <input type="checkbox"/> (Flat) <input type="checkbox"/> (Level)			
(4) Purpose of Well: <u>Other</u> (Domestic Irrigation Municipal, Industrial, Other)			
Information upon completion of well:			
(1) Diameter <u>2</u> inches.			
(2) Total Depth <u>60</u> feet.			
(3) Water Level <u>30</u> feet below top of ground.			
(4) Cased to <u>55'</u> , Size <u>2 1/2"</u>			
(5) Screen: Size <u>3 1/2"</u> , Length <u>5 ft.</u>			
(6) Were any formations sealed against pollution? <input type="checkbox"/> yes, <input type="checkbox"/> no.			
If YES depth of formation _____			
Why _____			
Drillers Remarks: <u>Plastic well</u>			
<u>outside screen</u>			

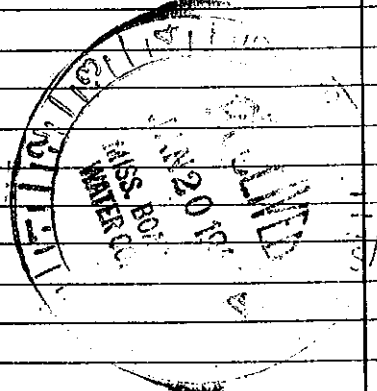

Well No.

(Use Back Side)

Mail this copy to Board of Water Commissioners 429 Miss. St. Jackson, Miss