

Lafayette  
N16

10-66 MISSISSIPPI BOARD OF WATER COMMISSIONERS

**WATER WELL DRILLERS LOG**

date: Oct. 21, 1966, Driller: Jerry Roberson County Lafayette  
(When well drilled) (Name) (Where well is located)

1) Owner of Land: Earl Neal  
(Name)  
Rt. 1, Water Valley, Miss.  
(Address)

2) Location: SW 1/4, SW 1/4, Sec. 23 T10 R 4  
  
4 1/2 miles NE, of Water Valley  
(distance) (direction) (Nearest Town)

3) Topography:  (Hilly)  (Flat)  (Level)

4) Purpose of Well: Home  
(Domestic Irrigation, Municipal, Industrial, Other)

| Description & Color of Materials<br>Sand, Clay, Red Clay, Shell, etc. | Thick-<br>ness<br>Feet | Depth<br>Feet |
|---|------------------------|---------------|
| <u>Red Clay + Sand</u>  | <u>20</u>              | <u>20</u>     |
| <u>Sand + Clay</u>  | <u>40</u>              | <u>60</u>     |
| <u>White Sand</u>   | <u>35</u>              | <u>95</u>     |

Information upon completion of well:

1) Diameter 4 inches.

2) Total Depth 95 feet.

3) Water Level 45 feet below top of ground.

4) Cased to 90, Size 4 in.

5) Screen: Size 6 in., Length 5 ft.

6) Were any formations sealed against pollution?  
yes,  no.

YES depth of formation


by

Drillers Remarks: Plastic Water Well

yield in gpm: 18

size pump: 1/2 H.P. Submenga

type power: 220-T.V.P.

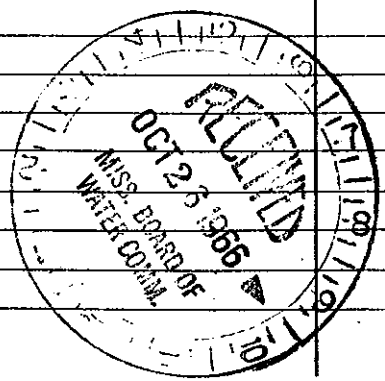

Mail this copy to Board of Water Commissioners 429 Miss. St. Jackson, Miss.