

State Well Report

Part 1

Mississippi Department of Environmental Quality
Office of Land and Water Resources
P.O. Box 10631
Jackson, MS 39289-0631
(601)961-5210
(601)354-6938 (fax)

For Office Use Only:

Aquifer: _____

Well #: N-37

L. S. Elevation: _____

E-log #: _____

County: Lafayette
Permit #: _____
Driller: Leeper Drilling
Date drilling completed: 5/29/07

State Law requires that this report be prepared by the driller in detail and filed with the Department within 30 days of completion of drilling of the well.

Well Owner Information

Owner Name: Sanford Thomas

Mailing Address: CR 385

Oxford, MS 38655
City State Zip Code

Telephone No. (662) 801-9464

Well Location

Latitude: _____ Longitude: _____

Method of Lat/Long (circle one): Conventional Survey,

USGS quad, Hand-held GPS, Survey-grade GPS

1/4 Sec 20 Twn 10 S Rng 4 W

Distance 12 Miles Direction South of Nearest Town Oxford

Well Data

Purpose of Well (circle one) Home Industrial Public Supply Irrigation Fish Culture Other: _____

Date well drilling started: 5-24-07 Date well drilling completed: 5-29-07

If flowing, method of flow regulation: Valve _____ Other (describe) _____

Static Water Level: 190 feet above or below (circle one) land surface Date measured: 5-30-07

Method of Measurement (circle one) steel tape electric tape air line other: _____

Hole depth: 360 ft Well depth: 360 ft Well grouted to a depth of 10 feet

Type of grout (circle one): Cement Bentonite Mix

Casing length: 330 feet Casing diameter: 4" inches Type of casing: PVC

Screen length: 30 feet Screen diameter: 4" inches Type of screen: PVC

Screen slot size: .010 inches Setting depth: From 330 feet to 360 feet

Type of completion (circle all applicable): Gravel packed Underreamed Telescoped Open hole Natural Development
Other (describe): _____

Top of lap pipe or reduction in casing: _____ feet. If telescoped or more than one screen, describe on back of page

Logs run (circle all applicable): No log run Electric Gamma Ray Density Sonic Neutron Other: _____

Name of organization running log(s): _____

I certify that the well was drilled, constructed, and completed in accordance with all applicable requirements of the Mississippi Department of Environmental Quality and/or the Mississippi Department of Health regulations and state laws.

Leeper Drilling # 0079

Print Name of Water Well Contractor and License No.

Signature of Water Well Contractor


RECEIVED

JUL 02 2007

BY: OLWR

If well telescopes please sketch below and show depths.


N-37

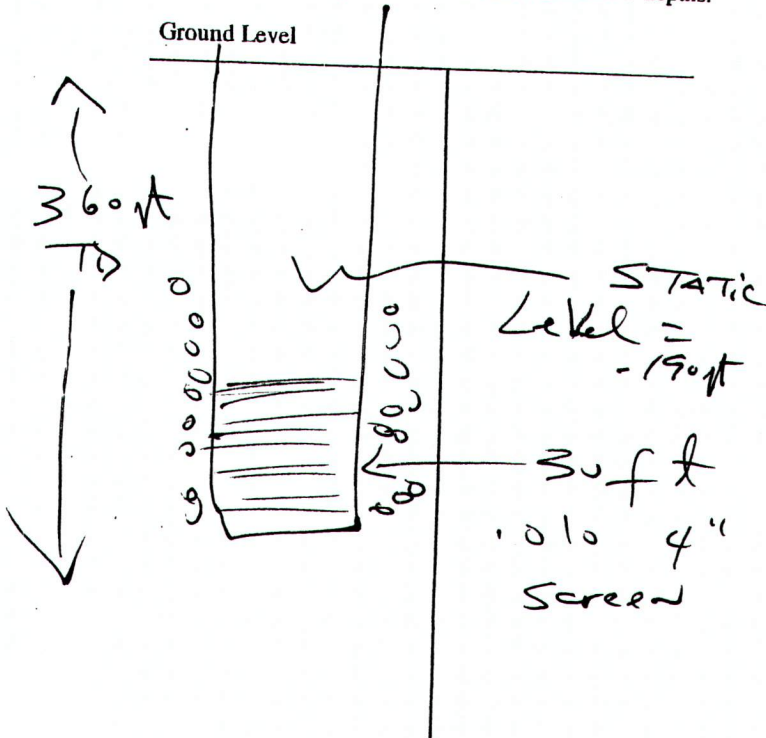


Description of Formations Encountered	From	To
Top Red Clay	0	5
Red Sand	5	30
Brown Sand	30	60
Gray, Black Blue clays	60	300
Silty Clay	300	330
fine Sand	330	360

If more than one screen, show location of each on sketch

Sketch the property layout and include the following: 1) the well location; 2) any permanent structures on the property that may aid in locating the well; 3) any roads, power lines, or other items that may aid in locating the property and the well; 4) indicate direction.

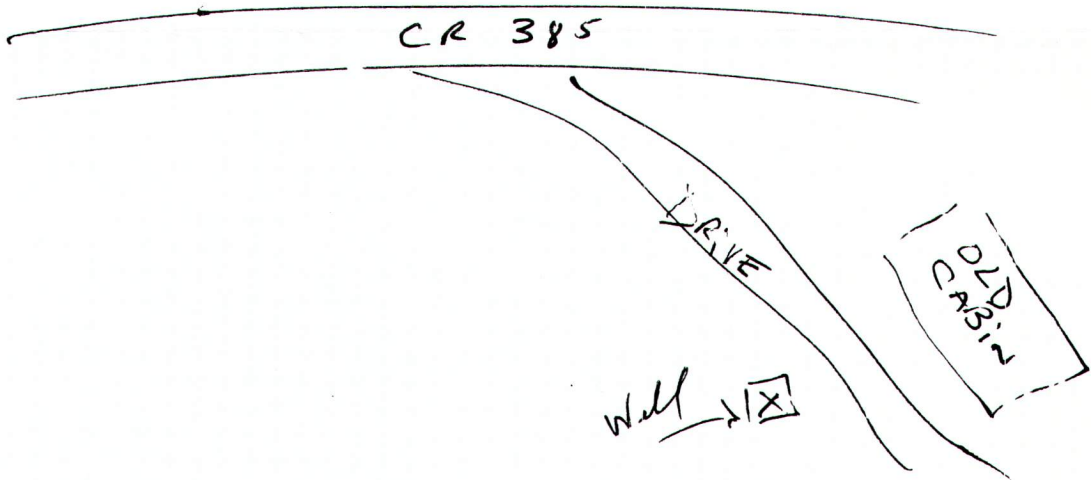

Landowner Name: Sanford Thomas

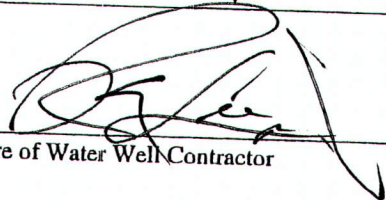

 Signature of Water Well Contractor

RECEIVED
 JUL 02 2007
 BY: OLWR

STATE WELL REPORT

Part 2

Pump Installer's Completion Report
Mississippi Department of Environmental Quality
Office of Land and Water Resources
P.O. Box 10631
Jackson, MS 39289-0631
(601)961-5210
(601)354-6938 (fax)

For Office Use Only:

Aquifer: _____

Well #: N-37

Elevation: _____

County: Lafayette
Permit #: _____
Driller: Leeper Drilling
Date completed: 5-30-07

This report should be prepared by the pump installer in detail and filed with the Department within 30 days of the installation of pump.

Well Owner Information	Well Location
Owner Name: <u>Sanford Thomas</u>	Latitude: _____ Longitude: _____
Mailing Address: <u>CR 385</u>	Method of Lat/Long (circle one): <input type="checkbox"/> Conventional Survey, <input type="checkbox"/> USGS quad, <input type="checkbox"/> Hand-held GPS, <input type="checkbox"/> Survey-grade GPS
<u>Oxford</u> <u>MS</u> <u>38655</u>	<u>1/4</u> <u>1/4</u> Sec <u>20</u> Twn <u>10S</u> Rng <u>4W</u>
City State Zip Code	Distance Direction Nearest Town
Telephone No. <u>(662) 801-9464</u>	<u>12</u> Miles <u>South</u> of <u>Oxford</u>

Pump Type Circle one	Power Type Circle one
Air Lift Jet <input type="checkbox"/> <u>Submersible</u>	Diesel Engine <input type="checkbox"/> Gasoline Engine <input type="checkbox"/> Natural Gas <input type="checkbox"/>
Bucket Piston <input type="checkbox"/> Turbine <input type="checkbox"/>	<u>Electric Motor</u> <input type="checkbox"/> Hand <input type="checkbox"/> Tractor PTO <input type="checkbox"/>
Centrifugal Rotary <input type="checkbox"/> Flowing Well <input type="checkbox"/>	Windmill <input type="checkbox"/> Other (specify): _____
Other (specify): _____	Horse Power Rating of Motor: <u>1 HP</u>
Date Pump Installed: <u>5/30/07</u>	Setting Depth: <u>240</u> feet
Rated Pump Capacity: <u>10</u> Gallons Per Minute	Number of Stages: <u>14</u>

Pump Test Data	Method of Measuring Water Level Circle one
Date Well Tested: <u>5-30-07</u>	Air Line <input type="checkbox"/> Electric Measuring Line <input type="checkbox"/> <u>Steel Tape</u>
Static Water Level (A): <u>190</u> Feet <u>Below</u> Land Surface	Other (specify): _____
Pumping Water Level (B): _____ Feet Below Land Surface	For flowing well, measured shut in head: _____ feet
Drawdown [(B) - (A)]: _____ Feet Below Land Surface	Well yielded _____ GPM with a drawdown of _____ feet after _____ hours of pumping
Test Pumping Rate: _____ Gallons Per Minute	
Duration of Pump Test (minimum 4 hours): _____ hours	

I HEREBY CERTIFY that the above statements are true to the best of my knowledge.
Leeper Drilling # 0079
Print Name of Pump Installer and License No. (if applicable) _____
Signature of Pump Installer [Signature]

RECEIVED
JUL 02 2007
BY: OLWR