

LAFAY.  
 03  
 9-4-65

MISSISSIPPI BOARD OF WATER COMMISSIONERS

WATER WELL DRILLERS LOG


Date: 9-4, 1965, Driller: Garry Pederson County Panola  
 (Name)

(1) Owner of Land:	Description & Color of Materials Sand, Clay, Red Clay, Shell, etc.	Thick- ness Feet	Depth Feet
<u>Mr. Percy Melton</u> (Name) <u>Paris</u> (Address) <u>Miss</u>	<u>Clay</u>	<u>0</u>	<u>70</u>
(2) Location: <u>1/4</u> , <u>1/4</u> , Sec. <u>25 T10 R3</u>	<u>Shell</u>	<u>70</u>	<u>110</u>
<u>1/4</u> miles, of <u>Paris</u> (distance) (direction) (Nearest Town)	<u>Clay</u>	<u>110</u>	<u>225</u>
(3) Topography: <u>←</u>	<u>sand</u>	<u>225</u>	<u>255</u>
(4) Purpose of Well: <u>Home</u> (Domestic Irrigation Municipal, Industrial, Other)			

Information upon completion of well:

- (1) Diameter 4 inches.
- (2) Total Depth 255 feet.
- (3) Water Level 68 feet below top of ground.
- (4) Cased to 200, Size 4 in.
- (5) Screen: Size open, Length bottom.
- (6) Were any formations sealed against pollution?  
 yes,  no.

If YES depth of formation \_\_\_\_\_  
 Why \_\_\_\_\_  
 Drillers Remarks: Plastic well

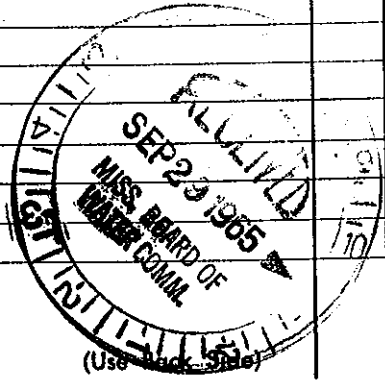

Well No. \_\_\_\_\_