
/	l Brate A	ven keport		
County: LA fayette		Part 1	For Office Use Only:	
Permit #:	Mississippi Department of Environmental Quality		1	
<del></del>	Office of Land	and Water Resources	Aquifer:	
Driller: Leeper Drilling	P.O. Box 10631		Well #: <u>8 - 18</u>	
Date drilling completed: _//-/9-07	Jackson, MS 39289-0631		L. S. Elevation:	
	(601)34	)961-5210 54-6038 (for)		
State Law requires that this report be prepared by the driller in detail and filed with the Department 30 days of completion of drilling of the well.			E-log #:	
30 days of completion of drilling	ort be prepared by the	e driller in detail and filed w	ith the Department within	
Well Owner Informa	of the well.		one Department within	
· • · · · · · · · · · · · · · · · · · ·		Well	Location	
Owner Name John Kyle		Latitude: •	" Longitude:"	
Mailing Address: 157 CR424		· ·		
		Method of Lat/Long (circle on		
Water Valle us zon			GPS, Survey-grade GPS	
City State / Zip Code		¼ ¼ Sec_ / 3	Twn /oS Rng 3W	
Telephone No. (662) § 3 2 - 00	Dietanos Di		Nearest Town ofO X for d	
			or oxford	
	Well I	)ata		
Purpose of Well (circle one) Home Industrial Public Supply Irrigation Field Co.				
Date well drilling started: //-15-07  Date well drilling completed: //- 19-07  If flowing, method of flow resolution 1/2 is a supply started in the supply started in the supply started in the supply				
Te florida	Date v	vell drilling completed:	19-07	
valve	eOther (de	escribe)		
If flowing, method of flow regulation: Valve Other (describe)  Static Water Level: / (0 U feet above of below (circle one) land surface Date measured: / / - Z 0 - 0 7				
method of Measurement (circle one) steel tape electric tape air line others				
Hole depth: 350 Well depth	h: 350 yt	Well grouted to a depth of	/ U feet	
Hole depth: 350 Well depth: Well grouted to a depth of 10feet  Type of grout (circle one): Cement Bentonite Mix				
Casing length: 240 feet Casing diameter: 4 inches Type of casing: 100				
Screen length:feet Screen diameter:inches Type of screen: PVC				
Screen slot size:				
Type of completion (circle all applicable): Gravel packed Underreamed Telescoped Open hole Natural Development				
Other (describe):				
Top of lap pipe or reduction in casing:feet. If telescoped or more than one screen, describe on back of page				
Logs run (circle all applicable): No log run Electric Gamma Ray Density Sonic Neutron Other:				
Name of organization muning log(e).				
I certify that the well was drilled, constructed, and completed in accordance with all applicable requirements of the Mississippi  Department of Environmental Quality and/on the Mississippi				
Quanty and/or the Mississippi Department of Health regulations and state laws.				
Le epar Drilling # 0079				
Print Name of Water Well Contractor and License No.		Signature of Wa	ater Well Contractor	

RECEIVE

NOV 2 9 2007

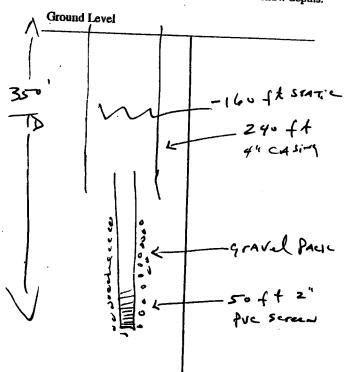

Description of Formations Encountered	From	To	
Red SANd.	0	Zu	1
Born Sard	Zu	6.	1
white Sand	60	90	1
O Laute O L			]
Black Blue			1
Green' Clays!	90	25	Ł
			Ī
silty sand	260	300	İ
SAN'S	300	350	,
			l
	1		
	1		
		_	

If more than one screen, show location of each on sketch

Sketch the property layout and include the following: 1) the well location; 2) any permanent structures on the property that may aid in locating the well; 3) any roads, power lines, or other items that may aid in location the may are manufactured to the
aid in locating the well; 3) any roads, power lines, or other items that may aid in locating the property that may 4) indicate direction.
- will
\\\\\\\\\\\\\\\\\\\\\\\\\\\\\\\\\\\\\\\
Hom E
ì
$\mathcal{L}_i$
. / /
CR 424
Landowner Name: \ \ \ \ \ \ \ \ \ \ \ \ \ \ \ \

Signature of Water Well Contractor

RECEIVED

NOV 2 9 2007

BY: OLWR

## STATE WELL REPORT

County:

Permit #:

Date completed: //- Zu-u7

Part 2 Pump Installer's Completion Report Mississippi Department of Environmental Quality Office of Land and Water Resources P.O. Box 10631 Jackson, MS 39289-0631 (601)961-5210

(601)354-6938 (fax)

For Office Use Only:		
Aquifer:		
Well #: _	b-18	

This report should be prepared by the pump installer in det	cil c_1 El. 1 10 in _
This report should be prepared by the pump installer in definition of pump.	and med with the Department within 30 days of the
Well Owner Information	
Owner Name: \a_k_1 \bullet. \alpha	Well Location
Owner Name: John Kyle	Latitude:Longitude:
Mailing Address: 157 CR 424	Method of Lat/Long (circle one): Conventional Survey,
14/4/201/4/1/2016	USGS quad, Hand-held GPS, Survey-grade GPS
City State / Zip Code	4 Sec_ / 3 Twn_ /o S Rng_ 3 W
Telephone No. (662) 832 - 005-4	Distance Direction Nearest Town
7 3 2 - 363 4	
Pump Type	
Circle one	Power Type Circle one
Air Lift Jet Submersible	Diesel Engine Gasoline Engine Natural Gas
Bucket Piston Turbine	Electric Motor Hand Tractor PTO
Centrifugal Rotary Flowing Well	Windmill Other (specify)
Other (specify):	Horse Power Rating of Motor: ( H ?
Date Pump Installed: //- 20 -6 7	Setting Depth: 220 feet
Rated Pump Capacity: Gallons Per Minute	Number of Stages: 14
Pump Test Data	Method of Manual Property
Date Well Tested: /(- 2 0 - 0 7	Method of Measuring Water Level Circle one
Static Water Level (A): 160 Feet Below Land Surface	Air Line Electric Measuring Line Steel Tape
Pumping Water Level (B):Feet Below Land Surface	Other (specify):
Drawdown [(B) - (A)]:Feet Below Land Surface	For flowing well, measured shut in head:fect
Test Pumping Rate:Gallons Per Minute	Well yieldedGPM with a drawdown of
Duration of Pump Test (minimum 4 hours):hours	feet afterhours of pumping
HEREBY CERTIEV that the above the	

tatements are true to the best of my knowledge Print Name of Pump Installer and License No. (if applicable) Signature of Pump Installer

RECEIVED

NOV 2 3 2007

BY: OLWR