

P5

2-18-63

WATER LOG

**CODED**

Date: 2-18, 1963, Driller: Elliott Hardware County Lafayette  
 (Name)

(1) Owner of Land: A. P. Elliott  
 (Name)  
Oxford, Miss.  
 (Address)

(2) Location: 1/4, NE 1/4, Sec. 12 T10S R1W  
0 miles W of Tula, Mu.  
 (distance) (direction) (Nearest Town)

(3) Topography: Hilly  
 (Hilly) (Flat) (Level)

(4) Purpose of Well: Small Water System  
 (Domestic Irrigation, Municipal, Industrial, Other)

Description & Color of Materials Sand, Clay, Red Clay, Shell, etc.	Thick- ness Feet	Depth Feet
<u>Red Clay</u>	<u>15</u>	<u>15</u>
<u>Black Clay</u>	<u>62</u>	<u>77</u>
<u>Black &amp; green clay</u>	<u>80</u>	<u>157</u>
<u>Hard BLUE clay</u>	<u>92</u>	<u>249</u>
<u>Strips of Sand &amp; Clay</u>	<u>21</u>	<u>270</u>
<u>Gray Sand</u>	<u>45</u>	<u>315</u>

Information upon completion of well

**CODED**

(1) Diameter 6 inches.

(2) Total Depth 315 feet.


(3) Water Level 220 feet below top of ground.

(4) Cased to No, Size No.

(5) Screen: Size 4", Length 20.

(6) Were any formations sealed against pollution?  
 yes,  no.

If YES, depth of formation 250 FT  
 Why With Cement Grout  
 Drillers Remarks: To Help Well

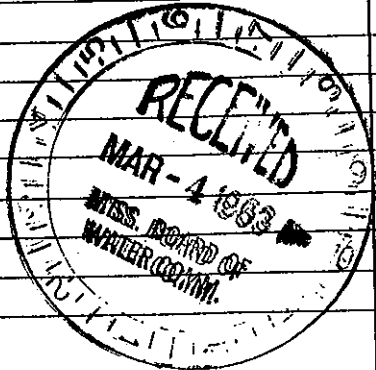

Well No.

(Use Back Side)