

STATE WELL REPORT

Part 1

Driller's Log

Mississippi Department of Environmental Quality
Office of Land and Water Resources
P.O. Box 2309
Jackson, MS 39225-2309
(601)961-5210
(601)360-0535 (fax)

For Office Use Only:

Well #: P11
Aquifer: _____
E-Log #: _____

County: La Fayette
Permit #: _____
Driller: Jones vs. Moser
Date drilling completed: 5-30-13

State Law requires that this report be prepared by the license holder responsible for the work and filed with the Department at the above address within 30 days of completion of drilling of the well or borehole.

Well Owner Information (Landowner if borehole is not for a water well)	Well or Borehole Location
Owner Name: <u>Brian Thurlow</u>	Latitude: <u>34°14'17.93</u> Longitude: <u>89°26'30.59</u>
Mailing Address: <u>443 cr 432</u>	Method of Lat/Long (check one): Conventional Survey <u>18</u> _____, <u>31</u>
<u>Oxford</u> <u>ms</u> <u>38655</u>	USGS quad _____, Hand-held GPS <input checked="" type="checkbox"/> , Survey-grade GPS _____
City State Zip Code	<u>NE</u> <u>1/4</u> <u>SE</u> <u>1/4</u> , Sec <u>6</u> <input checked="" type="checkbox"/> T <u>105</u> <input checked="" type="checkbox"/> R <u>20w</u>
Telephone No. (<u>662</u>) <u>202-6192</u>	<u>4 1/4</u> Miles <u>NE</u> of <u>Paris</u> (Distance) (Direction) (Nearest Town)

Well / Borehole Data

Date drilling started: 5-28-13 Date drilling completed: 5-30-13 Hole depth: 450 Hole diameter: 6 3/4
Location of the source of any surface water used for drilling: N/A
Method of dosing and volume of Chlorine used in drilling and development: 5 ppm and greater
Logs run (circle all applicable): No log run Electric Gamma Ray Density Sonic Neutron Other: _____
Name of organization running log(s): N/A
Purpose of borehole (circle one): Water Well Geotechnical/Geological Investigation Ground Source Heat Pump
 Seismic Survey Other (describe) N/A

If drilling is not related to water well construction, skip the remainder of this block

Purpose of Well (circle all applicable): Home Industrial Public Supply Irrigation Fish Culture
Other (describe): _____
If a flowing well, method of flow regulation: Valve N/A Other (describe) _____
Static Water Level: 180 feet [above or below] land surface Date measured: 5-30-2013
(circle one)
Method of measurement (circle one): Steel tape Electric tape Air line Other (describe): string weight
Well depth: 450 Well grouted to a depth of: 10 feet Type of grout (circle one): Neat Cement Bentonite Mix
Casing length: 410 feet Casing diameter: 4 inches Type of casing: pvc
Screen length: 40 feet Screen diameter: 4 inches Type of screen: pvc
Screen slot size: .010 inches Setting depth: From 410 feet to 450 feet
Type of completion (circle all applicable): Gravel packed Underreamed Open hole Natural Development
Other (describe): N/A
Top of lap pipe or reduction in casing: N/A feet

If telescoped or more than one screen, describe on next page

RECEIVED
JUN 28 2013


Form: DAWA-SWR-1A (1/13)
BY: OLWR

County: _____
 Permit #: _____

For Office Use Only:
 Well #: P11

The sketch below only required for water wells

If well telescopes, show depths on sketch.

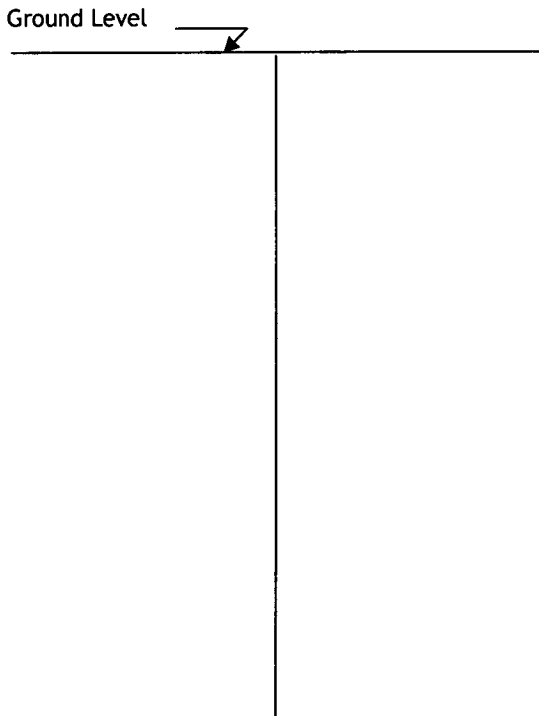


If more than one screen, show location of each on sketch

Description of formations encountered must be provided for all wells and boreholes, unless specifically exempted by regulations

Description of Formations Encountered	From (depth)	To (depth)
Clay dirt	Ground level	30
red sand	30	60
Black clay	60	75
red sand	75	85
Black clay	85	180
Rock	180	182
Black clay	182	300
Rock	300	301
Black clay	301	380
white sand	380	450

- Sketch the property layout and include the following:
- 1) the well location
 - 2) any permanent structures on the property that may aid in locating the well
 - 3) any roads, power lines, or other items that may aid in locating the property and the well
 - 4) north arrow

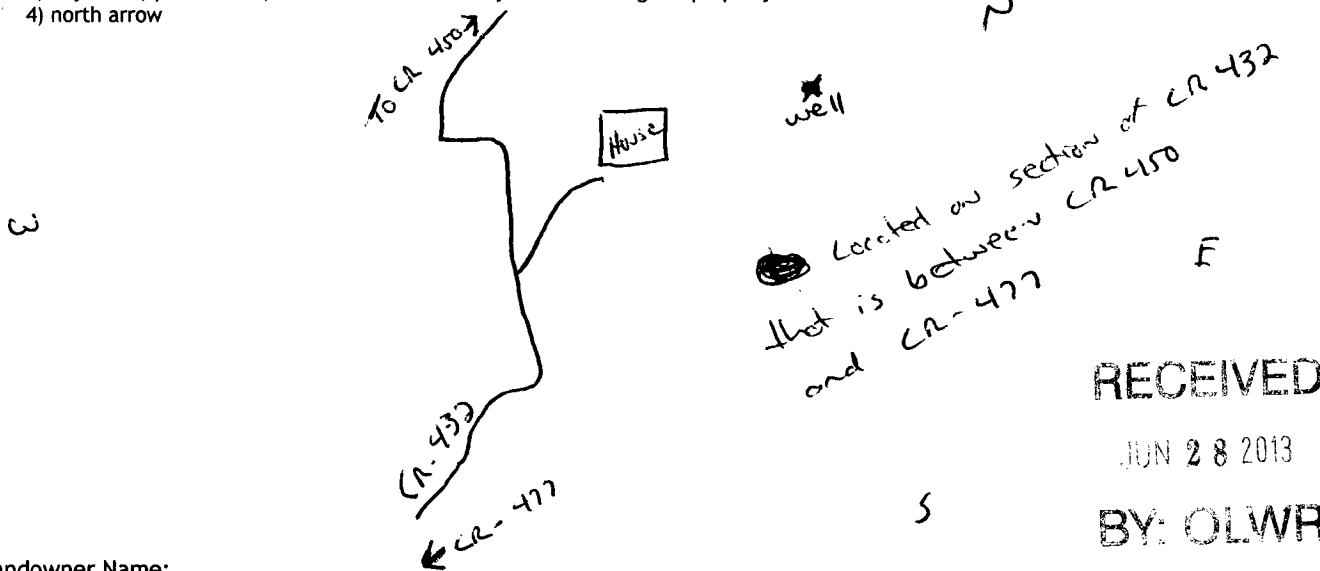

Landowner Name: _____

RECEIVED
 JUN 28 2013
 BY: OLWR

I HEREBY CERTIFY that the well/borehole was drilled, constructed, and completed in accordance with all applicable requirements of the Mississippi Department of Environmental Quality and the Mississippi Department of Health regulations, if applicable, and state laws.

Jones wr Mason 0-620 6-26-2013 Jones wr Mason
 Print Name of Responsible Licensee and License No. Date Signature of Licensee

STATE WELL REPORT

Part 2

Pump Installer's Completion Report
Mississippi Department of Environmental Quality
Office of Land and Water Resources
P.O. Box 2309
Jackson, MS 39225-2309
(601)961-5210
(601) 360-0535 (fax)

For Office Use Only:

Well #: P11
Aquifer: _____

County: Lafayette
Permit #: _____
Driller: Jones w. Mason
Date completed: 5-30-2013
Copy information from block on Part 1

This part of the report must be completed by a licensed water well contractor or a licensed pump installer. A copy of Part 1 of the report must be attached and both parts filed with the Department at the above address within 30 days of well completion.

Well Owner Information	Well Location
Owner Name: <u>Brian Thurlow</u>	Latitude: <u>34°14'17.93</u> Longitude: <u>89°26'30.59</u>
Mailing Address: <u>443 cr 432</u>	Method of Lat/Long (check one): Conventional Survey _____, USGS quad _____, Hand-held GPS <input checked="" type="checkbox"/> , Survey-grade GPS _____
<u>Oxford</u> <u>MS</u> <u>38655</u>	<u>NE 1/4 SE 1/4, Sec 6 T 10 S R 2 W</u>
City State Zip Code	<u>4 1/4</u> Miles <u>NE</u> of <u>Paris</u>
Telephone No. <u>(662) 202-6192</u>	(Distance) (Direction) (Nearest Town)

Pump Type (circle one)

Submersible Turbine Air Lift Centrifugal Flowing Well Jet Piston Rotary Other (describe): _____

Date Pump Installed: 5-30-2013 Rated Pump Capacity: 10 Gallons Per Minute

Is This Pump (circle one): New Repaired Replacement

Power Type (circle one)

Electric Diesel Gasoline Natural Gas Tractor PTO Windmill Other (describe): _____

Horse Power Rating of Motor: 1 Setting Depth: 300 feet Number of Stages: 11

Pump Test Data for Non Flowing Well

Date Well Tested: 5-30-2013 Duration of Pump Test (minimum 4 hours): 24 hours

Static Water Level (A): 180 Feet Below Land Surface Pumping Water Level (B): NA Feet Below Land Surface

Drawdown [(B) - (A)]: NA Feet Below Land Surface Test Pumping Rate: 10 Gallons Per Minute

Method of measurement (circle one): Steel tape Electric tape Air line Other (describe): string weight

Pump Test Data for Flowing Well

Measured shut in head: NA feet.

Well yielded 10 GPM with a drawdown of NA feet after 24 hours of pumping

Meter Installation

Meter Manufacturer: NA Meter Serial Number: NA

Meter Model Number/Name: NA Type of Meter: NA

Totalizer Register Unit and Multiplier Factor (AF x .001, gal x 1000, etc): NA

Installation Date: NA Meter installed by: NA

Is This Meter (circle one): New Repaired Replacement

Important: By submitting the above information you are certifying that this meter was installed to manufacturer standards. For agricultural wells, a list of approved meters is on the MDEQ website.

RECEIVED

I HEREBY CERTIFY that the above statements are true to the best of my knowledge.

JUN 28 2013

Jones w. Mason 0-620
Print Name of Pump Installer and License No. (if applicable)

6-26-2013
Date

Jones w. Mason
Signature of Pump Installer