

**LAMAR** MISSISSIPPI BOARD OF WATER COMMISSIONERS  
**A56**  
**5-27-66** *S & A Drilling*  
**WATER WELL DRILLERS LOG**

Date: 5/27, 1966, Driller: None County: Lamar  
 (Name)


(1) Owner of Land: T Lott  
 (Name)  
 Rt 2 Sumner  
 (Address)  
 (2) Location: 1/4, 1/4, Sec. 23 T. 5 R. 16  
2 1/2 miles SW, of Sumner  
 (distance) (direction) (Nearest Town)  
 (3) Topography: Hilly  
 (Hilly) (Flat) (Level)  
 (4) Purpose of Well: Home  
 (Domestic Irrigation  
 Municipal, Industrial, Other)

Description & Color of Materials Sand, Clay, Red Clay, Shell, etc.	Thick- ness Feet	Depth Feet
<u>Red Clay</u>	<u>4</u>	<u>4</u>
<u>Red Clay + Gravel</u>	<u>18</u>	<u>22</u>
<u>White + Pink Clay</u>	<u>23</u>	<u>45</u>
<u>White Sand of gravel</u>	<u>12</u>	<u>57</u>
<u>Fine white sand</u>	<u>48</u>	<u>105</u>
<u>good white sand</u>	<u>15</u>	<u>120</u>

Information upon completion of well:

(1) Diameter 4 inches.  
 (2) Total Depth 120 feet.  
 (3) Water Level 75 feet below top of ground.  
 (4) Cased to 115, Size 4"  
 (5) Screen: Size 4", Length 5ft.  
 (6) Were any formations sealed against pollution?  
yes,  no.

If YES depth of formation \_\_\_\_\_  
 Why \_\_\_\_\_  
 Drillers Remarks: \_\_\_\_\_

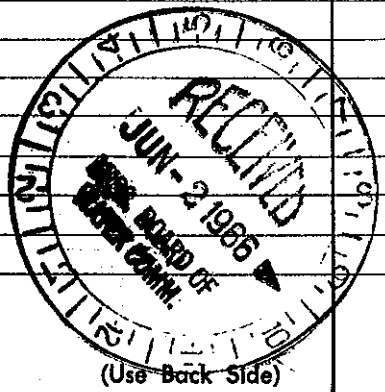

Well No. 27

all this copy to Board of Water Commissioners 429 Miss. St. Jackson, M.S.