

LAMAR MISSISSIPPI BOARD OF WATER COMMISSIONERS

A57  
5-31-66

S & R Drilling  
WATER WELL DRILLERS LOG


Date: 5/31, 1966, Driller: Mene County Lamar  
(Name)

(1) Owner of Land	Description & Color of Materials Sand, Clay, Red Clay, Shell, etc.	Thick- ness Feet	Depth Feet
<u>Billy Short</u> (Name)	<u>Clay &amp; Gravel</u>	<u>22</u>	<u>22</u>
<u>At 1 Sumrall</u> (Address)	<u>orange sand</u>	<u>35</u>	<u>57</u>
(2) Location: <u>1/4</u> , <u>1/4</u> , Sec. <u>16</u> T. <u>5</u> R. <u>6</u>	<u>pink clay</u>	<u>3</u>	<u>60</u>
<u>5</u> miles <u>NW</u> of <u>Sumrall</u> (distance) (direction) (Nearest Town)	<u>Brown Sand</u>	<u>28</u>	<u>88</u>
(3) Topography: <u>Hilly</u> (Hilly) (Flat) (Level)	<u>Strip white Clay &amp; Sand</u>	<u>13</u>	<u>101</u>
(4) Purpose of Well: <u>Home</u> (Domestic Irrigation Municipal, Industrial, Other)	<u>Sand &amp; Gravel</u>	<u>19</u>	<u>120</u>

Information upon completion of well:

- (1) Diameter 2" inches.
- (2) Total Depth 120 feet.
- (3) Water Level 60 feet below top of ground.
- (4) Cased to 115, Size 2"
- (5) Screen: Size 2", Length 5 ft
- (6) Were any formations sealed against pollution?  
 yes,  no.

If YES depth of formation \_\_\_\_\_  
Why \_\_\_\_\_  
Drillers Remarks: \_\_\_\_\_

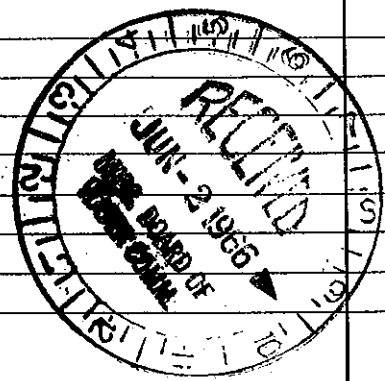

(Use Back Side)

This copy to Board of Water Commissioners 429 Miss. St. Jackson