

Lamar
 ALA
 9-5-68

MISSISSIPPI
 BOARD OF WATER COMMISSIONERS CODED
 416 North State Street
 Jackson, Mississippi 39201

WATER WELL DRILLERS LOG

9/5/68 1968 STR Lamar
 date well completed firm name county well located

LANDOWNER: C.M. Hester
 pt 1 Sumner
 (mailing address)


description of formations encountered	from	to
Clay	0	10
fine sand	10	30
sand & gravel	30	60
runty sand	60	70
stray sand & clay	70	80
fill sand	80	90
CWB sand	90	110

WELL LOCATION:
 sec 23 T 5 N R 16 E
 S W
 4 miles SW of Sumner
 (distance) (direction) (nearest town)

WELL PURPOSE: Home
 (home, irrigation, municipal, industrial)

WELL COMPLETION DATA:

- (1) diameter (inches) 2"
- (2) total depth (feet) 110
- (3) static water level (feet) 46 below above top of ground.
- (4) casing plastic, 105' (material) (depth)
 2" (size) if telescope see back.
- (5) screen 5 ft 105' (length) (depth to top)
 2" (size) plastic (material)
- (6) pump 1 (HP) 1000 gpm (yield gpm)
 Jet (type power)
- (7) electric log (yes or no)
 (organization running log)
- (8) how well bottom plugged Valve

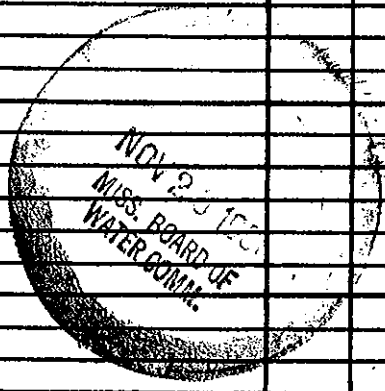

DRILLERS REMARKS: