

JAN-17-2002 05:29A FROM:

TO:16013600535

P:1

State Well Report

Part 1

Mississippi Department of Environmental Quality
 Office of Land and Water Resources
 P.O. Box 10631
 Jackson, MS 39289-0631
 (601)961-5210
 (601)954-6938 (fax)

County: Lamar
 Permit #: _____
 Driller: Travis Boone
 Date drilling completed: 4-17-08

For Office Use Only:
 Aquifer: _____
 Well #: A-168
 L.S. Elevation: _____
 B-log #: _____

State Law requires that this report be prepared by the driller in detail and filed with the Department within 30 days of completion of drilling of the well.

Well Owner Information	Well Location
Owner Name: <u>Jack Lucas</u>	Latitude: _____ " Longitude: _____ "
Mailing Address: <u>372 Hwy 42</u> <u>Sumrall, ms</u> <u>39482</u>	Method of Lat/Long (circle one): Conventional Survey, USGS quad, Hand-held GPS, Survey-grade GPS
City: _____ State: _____ Zip Code: _____	_____ 1/4 _____ 1/4 Sec <u>4</u> Twp <u>5N</u> Rng <u>16W</u>
Telephone No. () _____	Distance: <u>3 1/2</u> Miles Direction: <u>W</u> of Nearest Town: <u>Sumrall</u>

Well Data

Purpose of Well (circle one): Home Industrial Public Supply Irrigation Fish Culture Other: _____

Date well drilling started: 4-16-08 Date well drilling completed: 4-17-08

If flowing, method of flow regulation: Valve _____ Other (describe) _____

Static Water Level: 160 feet above or below (circle one) land surface Date measured: 4-17-08

Method of Measurement (circle one) steel tape electric tape air line other: String Line

Hole depth: _____ Well depth: 330 Well grouted to a depth of 10 feet

Type of grout (circle one): Concrete Bentonite Mix

Casing length: 310 feet Casing diameter: 4 inches Type of casing: sch 40

Screen length: 20 feet Screen diameter: 4 inches Type of screen: sch 40

Screen slot size: 8 inches Setting depth: From 310 feet to 330 feet

Type of completion (circle all applicable): Gravel packed Underdrained Telescoped Open hole Natural Development
 Other (describe): _____

Top of lap pipe or reduction in casing: _____ feet. If telescoped or more than one screen, describe on back of page

Logs run (circle all applicable): No log run Electric Gamma Ray Density Sonic Neutron Other: _____

Name of organization running log(s): _____

I certify that the well was drilled, constructed, and completed in accordance with all applicable requirements of the Mississippi Department of Environmental Quality and/or the Mississippi Department of Health regulations and state laws.

Travis Boone 0-514
 Print Name of Water Well Contractor and License No.

Travis Boone
 Signature of Water Well Contractor

RECEIVED
 MAY 16 2008
 BY: OLWR

JAN-17-2002 05:30A FROM:


TO: 16013600535

P:3

A-168

If well telescopes please sketch below and show depths.

Ground Level

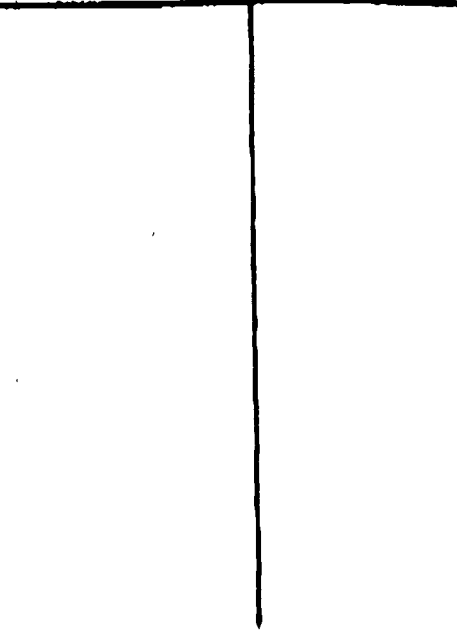

Description of Penetrating Equipment	From	To
Clay	0	120
Mud	120	135
Clay	135	225
Mud	225	235
Clay	235	285
Mud	285	330

If more than one screen, show location of each on sketch.

Sketch the property layout and include the following: 1) the well location; 2) any permanent structures on the property that may aid in locating the well; 3) any roads, power lines, or other items that may aid in locating the property and the well; 4) indicate direction.

Landowner Name: Jack Lucas

Travis Boone
Signature of Well Well Contractor

RECEIVED
MAY 16 2008
BY: OLWR

JAN-17-2002 05:30A FROM:

TO:16013600535

P:2

STATE WELL REPORT

Part 2

Pump Installer's Completion Report
 Mississippi Department of Environmental Quality
 Office of Land and Water Resources
 P.O. Box 10051
 Jackson, MS 39200-0051
 (601)961-5210
 (601)254-6738 (fax)

County: Leflore
 Parish #: _____
 Diller: Travis Boone
 Date completed: 11-17-08

Per Office Use Only
 Asst: _____
 Well #: A-168
 Elevator: _____

This report should be prepared by the pump installer in detail and filed with the Department within 30 days of the installation of pump.

Well Owner Information	Well Location
Owner Name: <u>Jack Lucas</u>	Latitude: _____ Longitude: _____
Mailing Address: <u>372 Hwy 42</u> <u>Sumner, MS</u> <u>39482</u>	Method of Locating (circle one): <u>Conventional Survey</u> USGS quad, Hand-held GPS, Survey-grade GPS
City: _____ State: _____ Zip Code: _____	_____ N _____ S Sec. <u>4</u> Twp. <u>5N</u> Rng. <u>11W</u>
Telephone No. (_____) _____	Distance: _____ Direction: _____ Nearest Town: <u>Sumner</u>
	<u>3 1/2</u> miles <u>W</u> of _____

Pump Type Circle one	Power Type Circle one
Air Lift: <input type="checkbox"/> Jet: <input checked="" type="checkbox"/> <u>Submersible</u>	Diaphragm: <input type="checkbox"/> Gasoline Engine: <input type="checkbox"/> Natural Gas: <input type="checkbox"/>
Beacon: <input type="checkbox"/> Piston: <input type="checkbox"/> Turbine: <input type="checkbox"/>	<u>Electric Motor</u> : <input checked="" type="checkbox"/> Hand: <input type="checkbox"/> Tractor PTO: <input type="checkbox"/>
Centrifugal: <input type="checkbox"/> Rotary: <input type="checkbox"/> Floating Well: <input type="checkbox"/>	Windmill: <input type="checkbox"/> Other (specify): _____
Other (specify): _____	Phase Power Rating of Motor: _____
Date Pump Installed: <u>4-17-08</u>	Setting Depth: <u>200</u> feet
Rated Pump Capacity: <u>12</u> Gallons Per Minute	Number of Stages: _____

Pump Test Data	Method of Measuring Water Level Circle one
Date Well Tested: <u>4-17-08</u>	Air Line: <input type="checkbox"/> Electric Measuring Line: <input type="checkbox"/> Steel Tape: <input type="checkbox"/>
Static Water Level (A): <u>160</u> Feet Below Land Surface	Other (specify): <u>String Line</u>
Pumping Water Level (B): _____ Feet Below Land Surface	For flowing well, covered shut in least: _____ feet
Drawdown (D) - (A): _____ Feet Below Land Surface	Well yielded _____ GPM with a drawdown of _____ feet after _____ hours of pumping
Test Pumping Rate: <u>12.0E</u> Gallons Per Minute	
Duration of Pump Test (includes 4 hours): _____ hours	

I HEREBY CERTIFY that the above statements are true to the best of my knowledge.

Travis Boone
 Print Name of Pump Installer and License No. (if available)

Travis Boone RECEIVED
 Signature of Pump Installer

MAY 16 2008
 BY: OLWR