County: <u>Lamar</u> Permit #: <u>Driller: James M. Wells</u> Date drilling completed: <u>L-27-14</u> Mississippi Departr Office of Lan P Jackson (1)			
Well Owner Information (Landowner if borehole is not for a water well) Owner Name: David Moore Mailing Address: 123 Higgins Rd. Summall MS 39482	Latitude: <u>31 25379</u> Lon Method of Lat/Long (<i>check one</i> USGS quad, Hand-held G	ehole Location ngitude: 89°36,103 e): Conventional Survey, SPS, Survey-grade GPS, 35NR_16W	
SummallMS39482SummallNo </td			
	ng: <u>Punning Creek</u> nd development: <u>Granue</u> na Ray Density Sonic Neutro cal/Geological Investigation describe)	on Other: Ground Source Heat Pump	
Purpose of Well (circle all applicable): Home Industrial Other (describe): If a flowing well, method of flow regulation: Valve	Public Supply Irrigation Other (<i>describe</i>)	Fish Culture	
(circle one) Method of measurement (circle one) Steel tape Electric (Well depth: <u>305</u> Well grouted to a depth of: <u>10</u> for Casing length: <u>305</u> feet Casing diameter: Screen length: <u>305</u> feet Screen diameter: Screen slot size: <u></u> feet Screen diameter: Screen slot size: <u></u> Screen slot size: <u></u>	eet Type of grout (<i>circle one</i>) <u>4</u> inches Type of <u>4</u> inches Type of	:Bentonite Mix casing: screen: 325 RECEVED	
Other (<i>describe</i>): Top of lap pipe or reduction in casing:feet <i>If telescoped or more than o</i>	one screen, describe on next pa	BY: OLWP	

4


3

County: _	Lamar
Permit #:	

For Office Use Only: Well #: <u>A</u> 2072

The sketch below only required for water wells

If well telescopes, show depths on sketch.

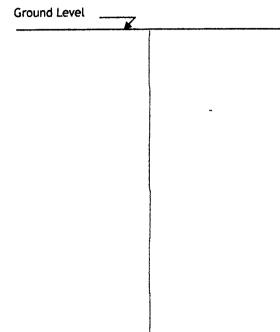

Description of formations encountered must be provided for all wells and boreholes, unless specifically exempted by regulations

Description of Formations Encountered	From (depth)	To (depth)
topso:1	Ground level)
Clay	1	280
Sand	280	325

If more than one screen, show location of each on sketch

Sketch the property layout and include the following:			
1) the well location			
 2) any permanent structures on the property that may aid in locating the well 3) any roads, power lines, or other items that may aid in locating the property and 	the well		
4) north arrow			
dic.			
38:			
x \\z			
U ,			
	DEOFO		
	RECEIVED		
11			
Hwy 42	$= \left(\left(\begin{array}{c} \frac{\partial f}{\partial t} & \frac{\partial f}{\partial t} \right) \right) \left(\left(\begin{array}{c} \frac{\partial f}{\partial t} & \frac{\partial f}{\partial t} \right) \right) \left(\left(\begin{array}{c} \frac{\partial f}{\partial t} \right) \right) \left(\left(\begin{array}{c} \frac{\partial f}{\partial t} \right) \right) \left(\left(\begin{array}{c} \frac{\partial f}{\partial t} \right) \right) \right) \left(\left(\begin{array}{c} \frac{\partial f}{\partial t} \right) \right) \left(\left(\left(\begin{array}{c} \frac{\partial f}{\partial t} \right) \right) \left(\left(\left(\begin{array}{c} \frac{\partial f}{\partial t} \right) \right) \left(\left(\left(\begin{array}{c} \frac{\partial f}{\partial t} \right) \right) \left(\left(\left(\left(\begin{array}{c} \frac{\partial f}{\partial t} \right) \right) \right) \left($		
	BY: OLWR		
	المحمد وسناح والمحمد المحمد		
Landowner Name: David Moore			
I HEREBY CERTIFY that the well/borehole was drilled, constructed, and completed in accordance with all applicable requirements of the Mississippi Department of Environmental Quality and the Mississippi Department of Health regulations,			
if applicable, and state laws.	mississippi department of mealth regulations,		
James M. 1.112/15 00005889 2-14-14	Same ni-ella		
Print Name of Responsible Licensee and License No. Date	Signature of Licensee		

STATE WELL REPORT				
County: Lamar	Part 2	For Office Use Only:		
	er's Completion Report			
	ment of Environmental Quality nd and Water Resources	Well #: 17202		
Date completed: 1-27-14	P.O. Box 2309			
Jacks	on, MS 39225-2309 601)961-5210	Aquifer:		
) 360-0535 (fax)	L		
This part of the report must be completed by a licensed water of the report must be attached and both parts filed with the L				
Well Owner Information	Welli	ocation		
Owner Name: David Moore	Latitude: 31 25.37.9" Lor	igitude: 89°36.10,3		
Mailing Address: 123 Higgins Kd.	Method of Lat/Long (check one			
	USGS quad, Hand-held G			
City State Zip Code	$\frac{300 4}{6} $ Miles $\frac{100 4}{6}$ or	<u>3 T5N RIGW</u>		
Telephone No. (601) 408-5554	(Distance) (Direction)	(Nearest Town)		
Pump Ty	pe (circle one)			
Submersible Turbine Air Lift Centrifugal Flowing Well	Jet Piston Rotary Other (de	scribe):		
Date Pump Installed: 1-27-14	Rated Pump Capacity:	Gallons Per Minute		
is This Pump (circle one): (New) Repaired Replaceme	nt p e (ci rcle one)			
Electric Diesel Gasoline Natural Gas Tractor PTO Wir				
Horse Power Rating of Motor: 1/2 Setting Dept				
Pump Test Data for Non Flowing Well Date Well Tested: 1-27-14 Duration of Pump Test (minimum 4 hours): 4 hours				
Static Water Level (A): 180 Feet Below Land Surface	Pumping Water Level (B): Q	250 Feet Below Land Surface		
Drawdown [(B) - (A)]: <u>195</u> Feet Below Land Sur	face Test Pumping Rate:	22 Gallons Per Minute		
Method of measurement (circle one): Steel tape) Electric ta				
	ta for Flowing Well			
Measured shut in head:feet.				
Well yieldedGPM with a drawdown of	feet after	hours of pumping		
Meter	Installation			
Meter Manufacturer:	Meter Serial Number:			
Meter Model Number/Name:	Type of Meter:			
Totalizer Register Unit and Multiplier Factor (AF x .001, ga	l x 1000, etc):			
Installation Date: Meter installed by:	••••••••••••••••••••••••••••••••••••••			
Is This Meter (circle one): New Repaired Replacement Important: By submitting the above information you are certifying that this meter was installed to manufacturer standards.				
For agricultural wells, a list of approved meters is on the MDEQ website.				
I HEREBY CERTIFY that the above statements are true to the best of my knowledge.				
James M. Hells 00005889 2-14-14 James M. cully				
Print Name of Pump Installer and License No. (<i>if applicable</i>) Date Signature of Pump Installer				
Form: OLWR-SWR-1B (4/13)				

2 1 5 6