

297

# STATE WELL REPORT

## Part 1

### Driller's Log

Mississippi Department of Environmental Quality  
Office of Land and Water Resources  
P.O. Box 2309  
Jackson, MS 39225-2309  
(601)961-5210  
(601)360-0535 (fax)

#### For Office Use Only:

Well #: 073A-210  
Aquifer: \_\_\_\_\_  
E-Log #: \_\_\_\_\_

County: Lamar  
Permit #: \_\_\_\_\_  
Driller: James M. Wells  
Date drilling completed: 1-10-19

State Law requires that this report be prepared by the license holder responsible for the work and filed with the Department at the above address within 30 days of completion of drilling of the well or borehole.

<p><b>Well Owner Information</b> (Landowner if borehole is not for a water well)</p> <p>Owner Name: <u>Justice Munn</u></p> <p>Mailing Address: <u>398 Munn Rd.</u> <u>Sumrall MS 39482</u></p> <p>City: <u>Sumrall</u> State: <u>MS</u> Zip Code: <u>39482</u></p> <p>Telephone No. (____) _____</p>	<p><b>Well or Borehole Location</b></p> <p>Latitude: <u>31°25.20'N</u> Longitude: <u>89°34.9'W</u> <u>31° 25' 20.33"</u> <u>89° 34' 11.81"</u></p> <p>Method of Lat/Long (check one): Conventional Survey _____</p> <p>USGS quad _____, Hand-held GPS _____, Survey-grade GPS _____</p> <p><u>SE ¼ SE ¼, Sec 2 T 5 N R 16 W</u></p> <p>_____ Miles _____ of _____ (Distance) (Direction) (Nearest Town)</p>
---	---

**Well / Borehole Data**

Date drilling started: 1-10-19 Date drilling completed: 1-10-19 Hole depth: 120 Hole diameter: 7 1/2"

Location of the source of any surface water used for drilling: Running creek

Method of dosing and volume of Chlorine used in drilling and development: granule chlorine

Logs run (circle all applicable): No log run Electric Gamma Ray Density Sonic Neutron Other: \_\_\_\_\_

Name of organization running log(s): \_\_\_\_\_

Purpose of borehole (circle one): Water Well Geotechnical/Geological Investigation Ground Source Heat Pump  
Seismic Survey Other (describe) \_\_\_\_\_

**RECEIVED**

**MAR 08 2019**

*If drilling is not related to water well construction, skip the remainder of this block*

Purpose of Well (circle all applicable): Home Industrial Public Supply Irrigation Fish Culture

Other (describe): \_\_\_\_\_

**BY OLWR**

If a flowing well, method of flow regulation: Valve \_\_\_\_\_ Other (describe) \_\_\_\_\_

Static Water Level: 50 feet [above or below land surface] (circle one) Date measured: 1-10-19

Method of measurement (circle one): Steel tape Electric tape Air line Other (describe): \_\_\_\_\_

Well depth: 120 Well grouted to a depth of: 10 feet Type of grout (circle one): Neat Cement Bentonite Mix

Casing length: 100 feet Casing diameter: 4 inches Type of casing: PVC

Screen length: 20 feet Screen diameter: 4 inches Type of screen: PVC

Screen slot size: .008 inches Setting depth: From 100 feet to 120 feet

Type of completion (circle all applicable): Gravel packed Underreamed Open hole Natural Development

Other (describe): \_\_\_\_\_

Top of lap pipe or reduction in casing: \_\_\_\_\_ feet

*If telescoped or more than one screen, describe on next page*

County: Lamar


Permit #: \_\_\_\_\_

For Office Use Only:

Well #: A 210

The sketch below only required for water wells

If well telescopes, show depths on sketch.

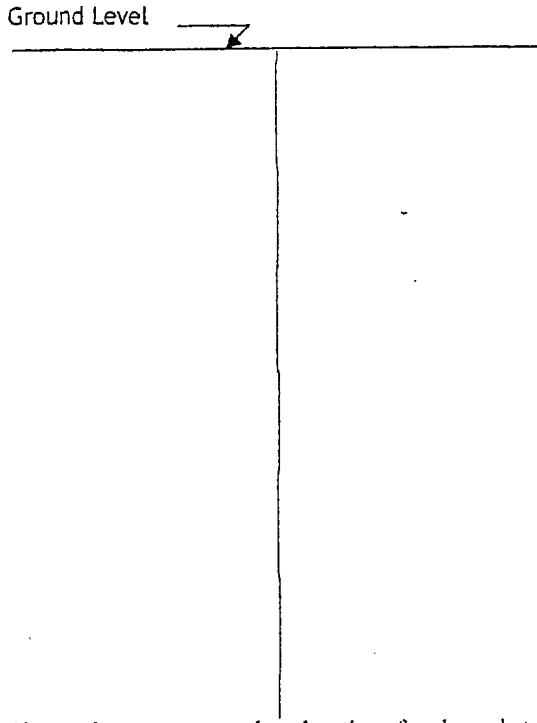


If more than one screen, show location of each on sketch

Description of formations encountered must be provided for all wells and boreholes, unless specifically exempted by regulations

Description of Formations Encountered	From (depth)	To (depth)
topsoil	Ground level	1
Clay	1	30
sand	30	120

Sketch the property layout and include the following:

- 1) the well location
- 2) any permanent structures on the property that may aid in locating the well
- 3) any roads, power lines, or other items that may aid in locating the property and the well
- 4) north arrow

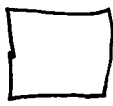

x well

RECEIVED  
 MAR 08 2019  
 BY OLWR



Landowner Name: Justice Mann

I HEREBY CERTIFY that the well/borehole was drilled, constructed, and completed in accordance with all applicable requirements of the Mississippi Department of Environmental Quality and the Mississippi Department of Health regulations, if applicable, and state laws.

James M. Wells 00005889  
 Print Name of Responsible Licensee and License No.

3-4-19  
 Date

James M. Wells  
 Signature of Licensee

# STATE WELL REPORT

## Part 2

**Pump Installer's Completion Report**  
 Mississippi Department of Environmental Quality  
 Office of Land and Water Resources  
 P.O. Box 2309  
 Jackson, MS 39225-2309  
 (601)961-5210  
 (601) 360-0535 (fax)

County: Lamar  
 Permit #: \_\_\_\_\_  
 Driller: James M. Wells  
 Date completed: 1-10-19  
*Copy information from block on Part 1*

**For Office Use Only:**

Well #: C 73 A 210  
 Aquifer: \_\_\_\_\_

*This part of the report must be completed by a licensed water well contractor or a licensed pump installer. A copy of Part 1 of the report must be attached and both parts filed with the Department at the above address within 30 days of well completion.*

Well Owner Information	Well Location
Owner Name: <u>Justice Munn</u>	Latitude: <u>31° 25.20' N</u> Longitude: <u>89° 34.9' W</u> <small>31° 25' 20.33" 89° 34' 11.81"</small>
Mailing Address: _____ <u>398 Munn Rd.</u>	Method of Lat/Long (check one): Conventional Survey _____, USGS quad _____, Hand-held GPS _____, Survey-grade GPS _____
<u>Sumrall</u> City <u>MS</u> State <u>39482</u> Zip Code	<u>SE</u> ¼ <u>SE</u> ¼, Sec <u>2</u> T <u>5 N</u> R <u>16 W</u>
Telephone No. (____) _____	____ Miles ____ of ____ (Distance) (Direction) (Nearest Town)

**Pump Type (circle one)**

Submersible    Turbine    Air Lift    Centrifugal    Flowing Well    Jet    Piston    Rotary    Other (describe): \_\_\_\_\_

Date Pump Installed: 1-10-19      Rated Pump Capacity: 25 Gallons Per Minute

Is This Pump (circle one):  New    Repaired    Replacement

**Power Type (circle one)**

Electric    Diesel    Gasoline    Natural Gas    Tractor PTO    Windmill    Other (describe): \_\_\_\_\_

Horse Power Rating of Motor: 2      Setting Depth: 100 feet      Number of Stages: \_\_\_\_\_

**RECEIVED**  
 MAR 08 2019  
 BY OLWR

**Pump Test Data for Non Flowing Well**

Date Well Tested: 1-10-19      Duration of Pump Test (minimum 4 hours): 4 hours

Static Water Level (A): 50 Feet Below Land Surface      Pumping Water Level (B): 100 Feet Below Land Surface

Drawdown [(B) - (A)]: 62 Feet Below Land Surface      Test Pumping Rate: 32 Gallons Per Minute

Method of measurement (circle one):  Steel tape    Electric tape    Air line    Other (describe): \_\_\_\_\_

**Pump Test Data for Flowing Well**

Measured shut in head: \_\_\_\_\_ feet.

Well yielded \_\_\_\_\_ GPM with a drawdown of \_\_\_\_\_ feet after \_\_\_\_\_ hours of pumping

**Meter Installation**

Meter Manufacturer: \_\_\_\_\_      Meter Serial Number: \_\_\_\_\_

Meter Model Number/Name: \_\_\_\_\_      Type of Meter: \_\_\_\_\_

Totalizer Register Unit and Multiplier Factor (AF x .001, gal x 1000, etc): \_\_\_\_\_

Installation Date: \_\_\_\_\_      Meter installed by: \_\_\_\_\_

Is This Meter (circle one):    New    Repaired    Replacement

*Important: By submitting the above information you are certifying that this meter was installed to manufacturer standards. For agricultural wells, a list of approved meters is on the MDEQ website.*

I HEREBY CERTIFY that the above statements are true to the best of my knowledge.

James M. Wells    00005889    3-4-19    James M. Wells  
 Print Name of Pump Installer and License No. (if applicable)      Date      Signature of Pump Installer