


LAMAR  
A 2019  
10-30-80

MISSISSIPPI  
BOARD OF WATER COMMISSIONERS  
416 North State Street  
Jackson, Mississippi 39201

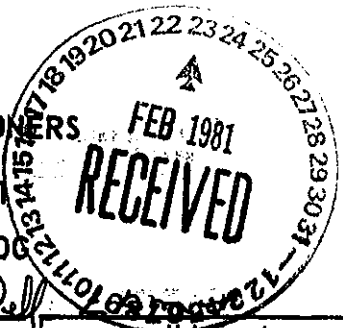

WATER WELL DRILLERS LOG

Oct. 30 1980 Tom Smith pl. Well  
date well completed firm name county well located

LANDOWNER: <u>Charlie James</u>	description of formations encountered	from	to
(mailing address)			
<p>WELL LOCATION:</p> <p>sec. <u>20</u> T. <u>S</u> N. R. <u>16</u> W.</p> <p><u>6</u> miles <u>West</u> of <u>Sumner</u></p> <p>(distance) (direction) (nearest town)</p>	<p>TOP SOIL 0 3</p> <p>Red sand 3 20</p> <p>Clay 20 140</p> <p>Sand 140 220</p>		
<p>WELL PURPOSE: <u>Home</u></p> <p>(home, irrigation, municipal, industrial)</p>			
<p>WELL COMPLETION DATA:</p>			
(1) diameter (inches) <u>4"</u>			
(2) total depth (feet) <u>220</u>			
(3) static water level (feet) <u>130</u> below top of ground.			
(4) casing <u>Sheet 220</u> (material) (depth)			
(size) If telescope see back.			
(5) screen <u>20</u> , <u>220-200</u> (length) (depth to top)			
<u>4</u> , <u>Sheet</u> (size) (material)			
(6) pump <u>1</u> (HP) (yield gpm)			
<u>1/2</u> (type power)			
(7) electric log _____ (yes or no)			
(organization running log)			
(8) how well bottom plugged <u>BW, D.</u>			
<p>DRILLERS REMARKS:</p>			

SEPT. OF NATURAL RESOURCES  
BUREAU OF LAND & WATER RESOURCES

