

MISSISSIPPI
BOARD OF WATER COMMISSIONERS

416 North State Street
Jackson, Mississippi 39201

WATER WELL DRILLERS LOG

Lamar
B12
1/68
Elec Log


1-26 1968 Lamar Central Co. Lamar
date well completed firm name county well located

LANDOWNER: <u>Town of Sumner, Miss.</u> (mailing address)	description of formations encountered	from	to
	Clay	0	40
	Clay streaks of sand	40	80
	Shale	80	150
WELL LOCATION: <u>Water Works Plant</u> sec. <u>7</u> T. <u>5</u> N. R. <u>15</u> E. S. <u>5</u>	<u>Gumby Shales</u>	150	280
<u>7</u> miles <u>W</u> of <u>Sumner</u> (distance) (direction) (nearest town)	<u>Sandy Shales</u>	280	300
	<u>Shale</u>	300	362
	<u>Shale</u>	362	370

WELL PURPOSE: Municipal
(home, irrigation, municipal, industrial)

WELL COMPLETION DATA:

- (1) diameter (inches) 10"
- (2) total depth (feet) 362'
- (3) static water level (feet) 65 below above top of ground.
- (4) casing Stub, 300'
(material) (depth)
(size) if telescope see back.
- (5) screen 50', 308'
(length) (depth to top)
6", Stainless Steel
(size) (material)
- (6) pump 20 (HP) (yield gpm)
Electric
(type power)
- (7) electric log yes
(yes or no)
Miss. Geo. Survey
(organization running log)
- (8) how well bottom plugged Gravel + Cement

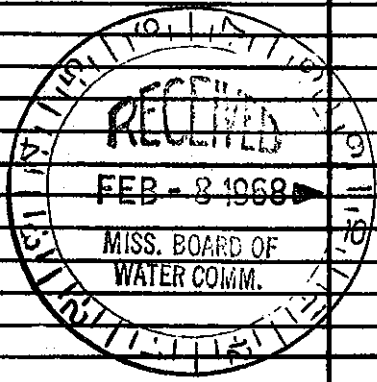

DRILLERS REMARKS:
Pump not installed as of this date - no test run