

LAMAR
B 30

MISSISSIPPI BOARD OF WATER COMMISSIONERS

10-12-60

WATER WELL DRILLERS LOG

D-300

Date: 10-12, 1960, Driller: Luck & Grace County: LAMAR

(Name)

(1) Owner of Land:	Description & Color of Materials Sand, Clay, Red Clay, Shell, etc.	Thick- ness Feet	Depth Feet
Ed. Wiggins (Name)	Surface sand red.	0	30
Hattiesburg R.F.D. (Address)	white clay	30	60
(2) Location: 1/4, 1/4, Sec. T R	sand & gravel	60	130
12 miles NW, of Hattiesburg (distance) (direction) (Nearest Town)			
(3) Topography: (Hill) (Flat) (Level)			
(4) Purpose of Well: Domestic (Domestic Irrigation, Municipal, Industrial, Other)			


Information upon completion of well:

- (1) Diameter 2 inches.
- (2) Total Depth 130 feet.
- (3) Water Level 75 feet below top of ground.
- (4) Cased to _____, Size _____
- (5) Screen: Size 2", Length 5'
- (6) Were any formations sealed against pollution?
_____ yes, _____ no.

If YES depth of formation _____

Why _____

Drillers Remarks: good well.

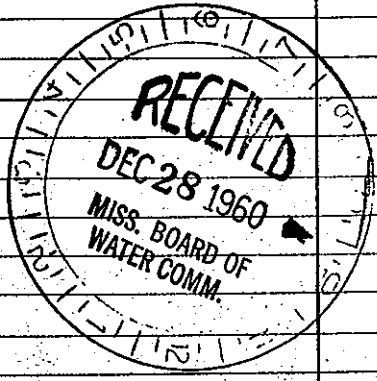

26
Well No

(Use Back Side)

Mail this copy to Board of Water Commissioners 429 Miss. St. Jackson, Miss.