

Lamar
B32
9-66

MISSISSIPPI BOARD OF WATER COMMISSIONERS

WATER WELL DRILLERS LOG

Date: 9-14-1966, Driller: *St. P. Drilling Inc.* County: *Lamar Forrest*
104 Thompson Blvd (Name) *Retal Miss.*


(1) Owner of Land: *William Fairley*
(Name)
Sumner Miss.
(Address)
(2) Location: *NE 1/4, NW 1/4, Sec. 6 T. 5 R. 15*
1 miles *NORTH* of *Sumner*
(distance) (direction) (Nearest Town)
(3) Topography: *Hilly*
(Hilly) (Flat) (Level)
(4) Purpose of Well: *Home*
(Domestic Irrigation
Municipal, Industrial, Other)

Description & Color of Materials Sand, Clay, Red Clay, Shell, etc.	Thick- ness Feet	Depth Feet
<i>Red clay</i>	<i>10</i>	<i>10</i>
<i>White clay + sand</i>	<i>20</i>	<i>30</i>
<i>" "</i>	<i>10</i>	<i>40</i>
<i>Fine sand</i>	<i>20</i>	<i>60</i>
<i>sand + clay</i>	<i>10</i>	<i>70</i>
<i>Hard sand</i>	<i>15</i>	<i>85</i>

Information upon completion of well:

- (1) Diameter *2* inches.
- (2) Total Depth *85* feet.
- (3) Water Level *52* feet below top of ground.
- (4) Cased to *80*, Size *2"*
- (5) Screen: Size *2"*, Length *5 ft*
- (6) Were any formations sealed against pollution?
yes, no.

If YES depth of formation _____
Why _____
Drillers Remarks: _____

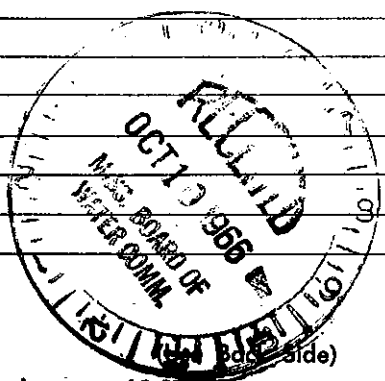

Well No. _____

Mail this copy to Board of Water Commissioners 429 Miss. St. Jackson, Miss.