

Lamar
B 35
9-16-68

MISSISSIPPI
BOARD OF WATER COMMISSIONERS
416 North State Street
Jackson, Mississippi 39201

CODED

WATER WELL DRILLERS LOG

9-16-68 date well completed
Leaman Throat firm name
Lamar County county well located

LANDOWNER:
W.F. Wright
Hattiesburg, Miss
(mailing address)

description of formations encountered	from	to
Chalk	0	112
Sand	112	130

WELL LOCATION:
sec. 22 T. 5 N. R. 15 E
S 5 miles E of Semball
(distance) (direction) (nearest town)

WELL PURPOSE:
(home, irrigation, municipal, industrial)

WELL COMPLETION DATA:

(1) diameter (inches) 2"

(2) total depth (feet) 130

(3) static water level (feet) 58 below above top of ground.


(4) casing Galv. 125' (material) (depth)
(size) If telescope see back.

(5) screen 5' 125' (length) (depth to top)
2" Plastic (size) (material)

(6) pump 1 (HP) 10 (yield gpm)
220 (type power)

(7) electric log no (yes or no)
(organization running log)

(8) how well bottom plugged B.P. Valve

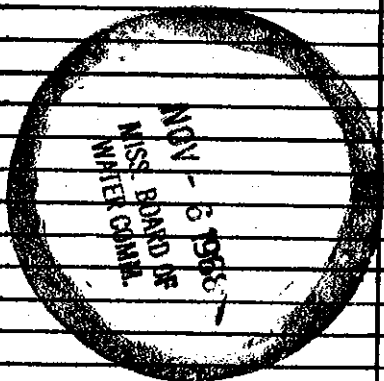

DRILLERS REMARKS: