

MISSISSIPPI BOARD OF WATER COMMISSIONERS

WATER WELL DRILLERS LOG

Carlross Well Supply Company

Date: 9-24-, 1963, Driller: Carlross Well Supply Co. County Lamar

(Name)

(1) Owner of Land: Town of Sumrall
(Name)
Sumrall, Mississippi
(Address)

(2) Location: NE 1/4, NE 1/4, Sec. 7 T5R15,
at Sumrall
(distance) miles (direction) (Nearest Town)

(3) Topography: Hilly
(Hilly) (Flat) (Level)

(4) Purpose of Well: Municipal
(Domestic Irrigation, Municipal, Industrial, Other)

Description & Color of Materials Sand, Clay, Red Clay, Shell, etc.	Thick-ness Feet	Depth Feet
Red Clay	16'	16'
Fine Sand W/ Strks. Clay	51'	67'
Med. to Coarse Sand	17'	84'
Soft White Shale or Chalk	80'	264'
Fine Sand	61'	325'
Medium Sand	11'	336'
Rock	2"	336'-2"
Blue Shale	57'-10"	394'
Shale	23'	417'
Sand w/ Strks. Shale	8'	425'
Shale	15'	440'
Sandy Shale w/ Strks. Sand	43'	483'
Sand	15'	498'
Shale	4'	502'

Information upon completion of well:

(1) Diameter 10 inches.

(2) Total Depth 370 feet.

(3) Water Level 74 feet below top of ground.

(4) Cased to 304', Size 10"


(5) Screen: Size 6", Length 60'-1"

(6) Were any formations sealed against pollution?
 yes, no.

If YES depth of formation Casing Cement
ed.

Why _____

Drillers Remarks:
Electric log #58

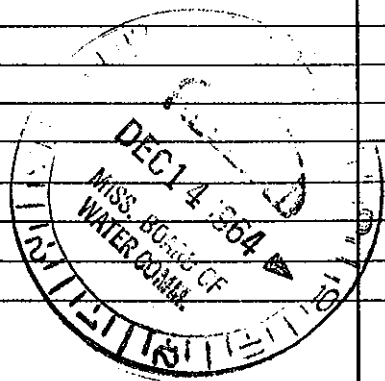

(Use Back Side)

Well No.

Mail this copy to Board of Water Commissioners 429 Miss. St. Jackson, Miss