

LAMAR MISSISSIPPI BOARD OF WATER COMMISSIONERS
 B38 WATER WELL DRILLERS LOG ~~Boo?~~

Date: 12-13-61, 1961, Driller: HERMON PARKER County LAMAR
 (Name)

(1) Owner of Land	Description & Color of Materials Sand, Clay, Red Clay, Shell, etc.	Thick- ness Feet	Depth Feet
Eugene Aultman (Name) Rt. 3 - Sumner, Miss (Address)	Red CLAY SAND + GRAVEL	22	22
(2) Location: _____ 1/4, _____ 1/4, Sec. <u>35</u> T <u>5</u> R <u>16</u>			
<u>6</u> miles <u>S-EAST</u> of <u>Sumner</u> (distance) (direction) (Nearest Town)			
(3) Topography: <u>Hilly</u> (Hilly) (Flat) (Level)			
(4) Purpose of Well: <u>Domestic</u> (Domestic Irrigation Municipal, Industrial, Other)			


Information upon completion of well:

- (1) Diameter 4 inches.
- (2) Total Depth 66 feet.
- (3) Water Level 35 feet below top of ground.
- (4) Cased to 66, Size 4"
- (5) Screen: Size 2 1/2", Length 5'
- (6) Were any formations sealed against pollution?
 yes, no.

If YES depth of formation _____

Why _____

Drillers Remarks: _____

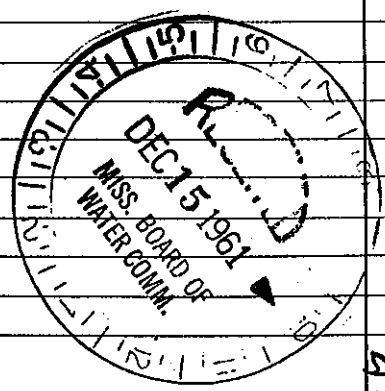

(Use Back Side)

22
Well No.