

MISSISSIPPI BOARD OF WATER COMMISSIONERS

LAMAR
 B 55
 6-20-62

WATER WELL DRILLERS LOG

CODED

Date: June 20, 1962, Driller: Jay Latt County Lamar
 (Name) Hathesburg Butane Gas Co. Hathesburg Miss.

(1) Owner of Land	Description & Color of Materials Sand, Clay, Red Clay, Shell, etc.	Thick- ness Feet	Depth Feet
(Name) <u>James Leon Lourey</u> (Address) <u>Rt 1 Hathesburg Miss</u>	yellow clay	0	15
(2) Location: <u>1/4</u> , <u>1/4</u> , Sec. <u>13</u> T <u>9</u> R <u>15</u>	white	15	30
<u>1/4</u> miles (distance), of <u>Hathesburg</u> (direction), of <u>Hathesburg</u> (Nearest Town)	blue	30	90
(3) Topography: _____ (Hilly) (Flat) (Level)	blue sand	90	115
(4) Purpose of Well: <u>Domestic</u> (Domestic Irrigation Municipal, Industrial, Other)			

Information upon completion of well:

- (1) Diameter 2 inches.
- (2) Total Depth 115 feet.
- (3) Water Level 60 feet below top of ground.
- (4) Cased to 2", Size 2".
- (5) Screen: Size 2", Length 10'.
- (6) Were any formations sealed against pollution?
 yes, no.


If YES depth of formation _____

Why _____

Drillers Remarks: _____

*Insufficient
 info to
 locate*

CODED

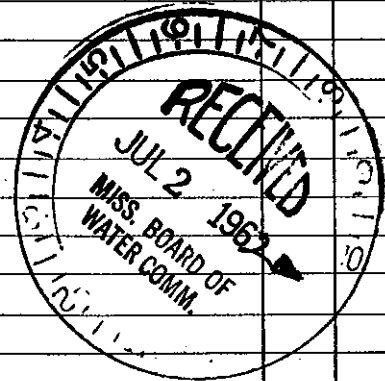

(Use Back Side)

Well No.

Mail this copy to Board of Water Commissioners 429 Miss. St. Jackson, Miss.