

County: LHMA
 Permit #: 0-586
 Driller: JAMES WELLS
 Date drilling completed: 5-11-11

State Well Report
Part 1 - Driller's Log
 Mississippi Department of Environmental Quality
 Office of Land and Water Resources
 P.O. Box 2309
 Jackson, MS 39225
 (601)961-5210
 (601)961-5228 (fax)

For Office Use Only:
 Aquifer: B114
 Well #: _____
 L. S. Elevation: _____
 E-log #: _____

State Law requires that this report be prepared by the license holder responsible for the work and filed with the Department at the above address within 30 days of completion of drilling of the well or borehole.

Information on Well Owner (Landowner if borehole is not for a water well)	Well or Borehole Location
Owner Name: <u>Alvin Dennis</u>	Latitude: <u>31.25.28</u> Longitude: <u>89.29.12</u>
Mailing Address: <u>345 Big Hill Rd</u> <u>Sumner MS 39482</u>	Method of Lat/Long (circle one): Conventional Survey, USGS quad, Hand-held GPS, Survey-grade GPS <u>N/2 1/4 S/2 1/4 Sec 3 Twn 5N Rng 15W</u>
City: _____ State: _____ Zip Code: _____	Distance: <u>4</u> Miles Direction: <u>NE</u> of Nearest Town: <u>Sumner</u>
Telephone No. (<u>601</u>) <u>4025318</u>	

Well / Borehole Data

Date drilling started: 5-11-11 Date drilling completed: 5-11-11 Hole depth: 200 Hole diameter: 7

Location of the source of any surface water used for drilling: Creek
 Method of dosing and volume of Chlorine used in drilling and development: Shock 300

Logs run (circle all applicable): No log run Electric Gamma Ray Density Sonic Neutron Other: _____
 Name of organization running log(s): _____

Purpose of borehole (check one): Water Well Geotechnical/Geological Investigation _____ Ground Source Heat Pump _____
 Seismic Survey _____ Other (describe) _____

If drilling is not related to water well construction, skip the remainder of this block

Purpose of Well (check one): Home _____ Industrial _____ Public Supply _____ Irrigation _____ Fish Culture _____ Other: _____

If a flowing well, method of flow regulation: Valve _____ Other (describe) _____

Static Water Level: 110 feet above or below (circle one) land surface Date measured: 5-11-11

Method of Measurement (circle one) steel tape electric tape air line other: _____

Well depth: 200 Well grouted to a depth of 10 feet Type of grout (circle one): Neat Cement Bentonite Mix

Casing length: 180 feet Casing diameter: 4 inches Type of casing: PVC

Screen length: 20 feet Screen diameter: 4 inches Type of screen: PVC

Screen slot size: .008 inches Setting depth: From 180 feet to 200 feet

Type of completion (circle all applicable): Gravel packed Underreamed Telescoped Open hole Natural Development
 Other (describe): _____

Top of lap pipe or reduction in casing: _____ feet. *If telescoped or more than one screen, describe on next page*

 
Form: OLWR-SWR-1A (04/08)


RECEIVED
 JUN 17 2011
 BY: OLWR

The sketch below only required for water wells

Description of formations encountered must be provided for all wells and boreholes, unless specifically exempted by regulations

If well telescopes, show depths on sketch.


Ground Level 

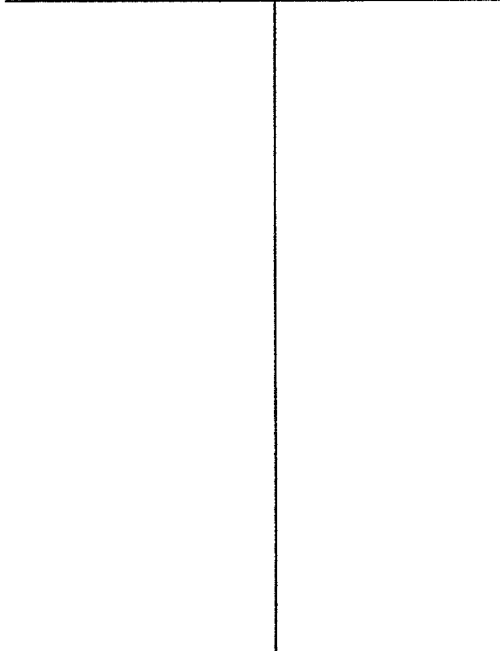

Description of Formations Encountered	From (depth)	To (depth)
	Ground Level	2
Clay	2	140
Sand	140	200

If more than one screen, show location of each on sketch

Sketch the property layout and include the following: 1) the well location; 2) any permanent structures on the property that may aid in locating the well; 3) any roads, power lines, or other items that may aid in locating the property and the well; 4) a north arrow.



RECEIVED
 JUN 17 2011
 BY: OIWR

Landowner Name: Alvin Downing

Form: OIWR-SWR-1A (04/08)

I certify that the well/borehole was drilled, constructed, and completed in accordance with all applicable requirements of the Mississippi Department of Environmental Quality and the Mississippi Department of Health regulations, if applicable, and state laws.

Print Name of Responsible Licensee and License No. JAMES WELLS 0-586 _____ Date _____

Signature of Licensee James Wells

STATE WELL REPORT

Part 2

Pump Installer's Completion Report
 Mississippi Department of Environmental Quality
 Office of Land and Water Resources
 P.O. Box 10631
 Jackson, MS 39289-0631
 (601)961-5210
 (601)354-6938 (fax)

For Office Use Only:

Aquifer: _____
 Well #: _____
 Elevation: _____

County: Lamar
 Permit #: _____
 Driller: JAMES WELLS
 Date completed: 5-11-11

This report should be prepared by the pump installer in detail and filed with the Department ~~within 30 days~~ of the installation of pump.

Well Owner Information	Well Location
Owner Name: <u>Alvin Downing</u>	Latitude: _____ Longitude: _____
Mailing Address: <u>345 Big Hill Rd</u>	Method of Lat/Long (circle one): <input type="radio"/> Conventional Survey,
<u>Sumrall MS</u>	<input type="radio"/> USGS quad, <input type="radio"/> Hand-held GPS, <input type="radio"/> Survey-grade GPS
City: _____ State: _____ Zip Code: <u>39482</u>	<input type="radio"/> 1/4 _____ 1/4 Sec <u>3</u> Twn <u>5N</u> Rng <u>15W</u>
Telephone No. <u>(601) 402 5318</u>	Distance _____ Direction _____ Nearest Town _____
	<u>2</u> Miles <u>NE</u> of <u>Sumrall MS</u>

Pump Type Circle one	Power Type Circle one
Air Lift <input type="radio"/> Jet <input type="radio"/> <u>Submersible</u>	Diesel Engine <input type="radio"/> Gasoline Engine <input type="radio"/> Natural Gas <input type="radio"/>
Bucket <input type="radio"/> Piston <input type="radio"/> Turbine <input type="radio"/>	<u>Electric Motor</u> <input type="radio"/> Hand <input type="radio"/> Tractor PTO <input type="radio"/>
Centrifugal <input type="radio"/> Rotary <input type="radio"/> Flowing Well <input type="radio"/>	Windmill <input type="radio"/> Other (specify): _____
Other (specify): _____	Horse Power Rating of Motor: <u>1</u>
Date Pump Installed: <u>5-11-11</u>	Setting Depth: <u>150</u> feet
Rated Pump Capacity: <u>15</u> Gallons Per Minute	Number of Stages: <u>14</u>

Pump Test Data	Method of Measuring Water Level Circle one
Date Well Tested: <u>5-11-11</u>	Air Line <input type="radio"/> Electric Measuring Line <input type="radio"/> <u>Steel Tape</u>
Static Water Level (A): <u>110</u> Feet Below Land Surface	Other (specify): _____
Pumping Water Level (B): <u>150</u> Feet Below Land Surface	For flowing well, measured shut in head: _____ feet
Drawdown [(B) - (A)]: <u>120</u> Feet Below Land Surface	Well yielded <u>15</u> GPM with a drawdown of
Test Pumping Rate: <u>15</u> Gallons Per Minute	<u>110</u> feet after <u>4</u> hours of pumping
Duration of Pump Test (minimum 4 hours): <u>4</u> hours	

I HEREBY CERTIFY that the above statements are true to the best of my knowledge.

JAMES WELLS 0-586
 Print Name of Pump Installer and License No. (if applicable)

James Wells
 Signature of Pump Installer

RECEIVED

JUN 17 2011

BY: OLWR