County: Lamar		ELL REPORT	E. Offer the second
		art 1	For Office Use Only:
Permit #:	Mississippi Departmer	l er's Log It of Environmental Qualit	Well #: 5130
Driller: James M. Wells	_ Office of Land a	and Water Resources Box 2309	Aquifer:
Date drilling completed: 2-22-16		MS 39225-2309	E-Log #:
)961-5210 0-0535 (fax)	
State Law requires that this repo Department at the above addres	ort be prepared by the lice s within 30 days of comple	nsa haldan namenatti o	r the work and filed with the I or horehole
Well Owner Inform (Landowner if borehole is not)	ation	313 Well or Bo	
		itude: 3121.060	ongitude: 89°30 128
<u></u>			····· /· ·····
Mailing Address:			ne): Conventional Survey,
44 Fillingane			GPS, Survey-grade GPS
Sumrall M	5 39482 1	JE 1/4 <u>JE 1/4</u> , Sec	<u>33 T 5N R 15W</u>
City State		1	of Sum rall
Telephone No. (10) 520-	1808 (Di	stance) (Direction)	(Nearest Town)
Date drilling started: $2 - 2 - 1 = 0$ Date Location of the source of any surface	water used for drilling:	Funning cree	K
Method of dosing and volume of Chlo	rine used in drilling and de	evelopment:	
Logs run (circle all applicable): to log	ryn Electric Gamma Ra	y Density Sonic Neutr	on Other:
Name of organization running log(s):			
Purpose of borehole (circle one): Wate			Ground Source Heat Pump
	nic Survey Other (descr		
Purpose of Woll (size of an in the	lated to water well constru		r of this block
	house		Fish Culture
If a flowing well, method of flow regu	lation: Valve	Other (describe)	
Static Water Level:fee	t [above or below] land	surface Date measured	
Method of measurement (circle one):	Steel tape Electric tape	Air line Other (describe):	
Well depth: <u>165</u> Well grouted to a	depth of: <u>10</u> feet	Vpe of grout (circle one)	Next Compt Bart
Casing length: 125 feet C	asing diameter:4		
LIN	11		
Screen slot size:	Setting depth: From	inches Type of s 125feet to	creen: <u>DVC</u>
Type of completion (circle all applicable		erreamed Open hole	Natural Development
Other (describe):			
Top of lap pipe or reduction in casing:	feet		APR 04
1	ped or more than one scr		1

1 1

_		_			w
Form:	OLW	'R-SWR	-1A	(4/ 1	3)


County: _	Lamar	
Permit #:		

1

]	For Office Use Only:	
Well #	: B130	

The sketch below only required for water wells

If well telescopes, show depths on sketch.

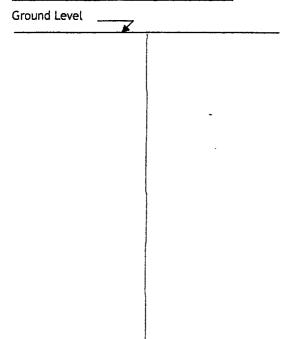

Description of formations encountered must be provided	for all	wells
and boreholes, unless specifically exempted by regulatio	ns	

Description of Formations Encountered	From (depth)	To (depth)
tupsoil	Ground level	1
clay Sant	1	120
Salt	120	120 165
- • •		
······		
·		

If more than one screen, show location of each on sketch

Sketch the property layout and include the following:

1) the well location 2) any permanent structures on the property that may aid in

3) any roads, power lines, or other items that may aid in locating the property and the well
4) north arrow Fillingene Rd.
oral Church Rd. John Received
Landowner Name: <u>C.4</u> Facens I HEREBY CERTIFY that the well/borehole was drilled, constructed, and completed in accordance with all applicable requirements of the Mississippi Department of Environmental Quality and the Mississippi Department of Health regulations, if applicable, and state laws.
Dames IM. Wells 00005889 3.29-16 James M. C.e.C. Print Name of Responsible Licensee and License No. Date Signature of Licensee

	STATE WE	LL REPO	RT		
County: Lama-		Part 2		For Off	ice Use Only:
Permit #:	Pump Installer Mississippi Departme	's Completion	n Keport ntal Quality	Woll #	130
Driller: Dames M. Wells	Office of Land	and Water Reso	urces	weit #	
Date completed: 2-22-16		D. Box 2309 , MS 39225-2309		Aquifer:	
Copy information from block on Part 1	(60)1)961-5210 360-0535 (fax)			
This part of the report must be completed of the report must be attached and both p	f by a licensed water v	vell contractor or	a licensed pur bove address w	np installer. Aithin 30 days	A copy of Part 1 of well completion.
Well Owner Informatic	on		Well L	ocation	
Owner Name: C++ Farm	25	Latitude: <u>31° a</u>	21.060 Lor	igitude: <u>89</u>	30.128
Mailing Address:	- 1				nal Survey,
44 Fillingade Rd					ey-grade GPS
44 Fillingane Rd.	05 201187		•		
Sumrall Gen. M City State	Zip Code				N _R 15W
Telephone No. (a) 520-48	· · ·	(Distance)	(Direction)	f <u> </u>	arest Town)
	Pump Typ	e (circle one)			
Submerstble Turbine Air Lift Centrifu				-	
Date Pump Installed: 2-22-11		ated Pump Capac	:ity: <u>5</u>	5	Gallons Per Minute
Is This Pump (circle one): Rep	aired Replacemen	t			
		e (circle one)			<u> </u>
Electric Diesel Gasoline Natural Gas	Tractor PTO Wind	mill Other (des	cribe):		- 1
Horse Power Rating of Motor:	Setting Depth	: 125	feet Number	of Stages: _	13
	Pump Test Data f	-			11
Date Well Tested: 2.22.16	······	Duration of Pur	np Test (<i>minin</i>	num 4 hours)	: <u> </u>
Static Water Level (A): 7.5 Feet	Below Land Surface	Pumping Wat	er Level (B)	<u>25</u> Feet	Below Land Surface
Drawdown [(B) - (A)]:	Feet Below Land Surfa	ice Test Pump	oing Rate:	65	Gallons Per Minute
Method of measurement (circle one):	eel tabe Electric tar	e Air line Oth	er (describe):		
	Pump Test Dat	a for Flowing W	ell		
Measured shut in head:feet.	1				
Well yieldedGPM with a d	rawdown of	feet after	-	_hours of pur	nping
	Meter II	nstallation			ā
Meter Manufacturer:		Meter Seri	al Number:		
Motor Model Number/Name:		Type of M	otor		
Totalizer Register Unit and Multiplier Fa	ctor (AF x .001. gal :	x 1000. etc):			
Totalizer Register Unit and Multiplier Fa	Neter installed by:				receive
Is This Meter (circle one): New Rep					
Important: By submitting the above in	·	rtifving that this n	neter was insta n the MDEO w	lled to manuj ebsite.	APR 04 2016 facturer standards.
I HEREBY CERTIFY that the above staten					By OLWI
		-	-		
James M. Wells 00005	889	3-24-16	tame	± ~.	curly
Print Name of Pump Installer and Licens	e No. (if applicable)	Date	Signa	ture of Pump	o Installer

а • •