

STATE WELL REPORT

375

County: Lamar
 Permit #: _____
 Driller: James M. Wells
 Date drilling completed: 12-17-18

Part 1
Driller's Log
 Mississippi Department of Environmental Quality
 Office of Land and Water Resources
 P.O. Box 2309
 Jackson, MS 39225-2309
 (601)961-5210
 (601)360-0535 (fax)

For Office Use Only:

Well #: B154
 Aquifer: _____
 E-Log #: _____

State Law requires that this report be prepared by the license holder responsible for the work and filed with the Department at the above address within 30 days of completion of drilling of the well or borehole.

Well Owner Information (Landowner if borehole is not for a water well)	Well or Borehole Location
Owner Name: <u>Ethan Applewhite</u>	Latitude: <u>31°24.43N</u> Longitude: <u>89°29.35W</u>
Mailing Address: _____	Method of Lat/Long (check one): Conventional Survey _____, <u>21 38.1</u> <u>32 53.06</u>
<u>268 Scruggs Rd.</u>	USGS quad _____, Hand-held GPS _____, Survey-grade GPS _____
<u>Surrell</u> <u>MS</u> <u>39482</u>	<u>NE 1/4 NW 1/4, Sec 31 T 5N R 15W</u>
City State Zip Code	_____ Miles _____ of _____ (Distance) (Direction) (Nearest Town)
Telephone No. (____) _____	


Well / Borehole Data
Date drilling started: <u>12-17-18</u> Date drilling completed: <u>12-17-18</u> Hole depth: <u>260</u> Hole diameter: <u>7 1/2"</u>
Location of the source of any surface water used for drilling: <u>running creek</u>
Method of dosing and volume of Chlorine used in drilling and development: <u>granule chlorine</u>
Logs run (circle all applicable): <u>No log run</u> Electric Gamma Ray Density Sonic Neutron Other: _____
Name of organization running log(s): _____
Purpose of borehole (circle one): <u>Water Well</u> Geotechnical/Geological Investigation Ground Source Heat Pump Seismic Survey Other (describe) _____
<i>If drilling is not related to water well construction, skip the remainder of this block</i>
Purpose of Well (circle all applicable): <u>Home</u> Industrial Public Supply Irrigation Fish Culture
Other (describe): _____
If a flowing well, method of flow regulation: Valve _____ Other (describe) _____
Static Water Level: <u>120</u> feet [above or <u>below</u> land surface] (circle one) Date measured: <u>12-17-18</u>
Method of measurement (circle one): <u>Steel tape</u> Electric tape Air line Other (describe): _____
Well depth: <u>260</u> Well grouted to a depth of: <u>10</u> feet Type of grout (circle one): <u>Neat Cement</u> Bentonite Mix
Casing length: <u>240</u> feet Casing diameter: <u>4</u> inches Type of casing: <u>PVC</u>
Screen length: <u>20</u> feet Screen diameter: <u>4</u> inches Type of screen: <u>PVC</u>
Screen slot size: <u>.008</u> inches Setting depth: From <u>240</u> feet to <u>260</u> feet
Type of completion (circle all applicable): <u>Gravel packed</u> Underreamed Open hole Natural Development
Other (describe): _____
Top of lap pipe or reduction in casing: _____ feet
<i>If telescoped or more than one screen, describe on next page</i>

RECEIVED
 FEB 20
 BY OLWR

County: Lamar
 Permit #: _____

For Office Use Only:
 Well #: B154

The sketch below only required for water wells
If well telescopes, show depths on sketch.

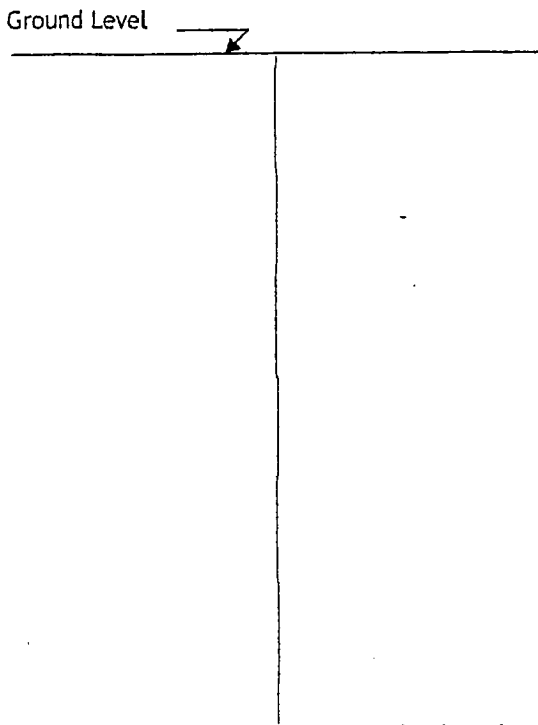


If more than one screen, show location of each on sketch

Description of formations encountered must be provided for all wells and boreholes, unless specifically exempted by regulations

Description of Formations Encountered	From (depth)	To (depth)
	Ground level	1
topsoil		
clay	1	195
sand	195	260

Sketch the property layout and include the following:
 1) the well location
 2) any permanent structures on the property that may aid in locating the well
 3) any roads, power lines, or other items that may aid in locating the property and the well
 4) north arrow

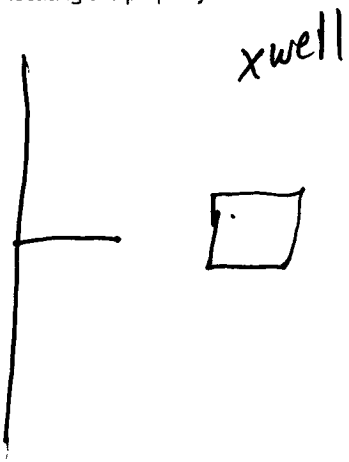

RECEIVED
 FEB 04 2019
 BY OLWR

Landowner Name: Ethan Applewhite

I HEREBY CERTIFY that the well/borehole was drilled, constructed, and completed in accordance with all applicable requirements of the Mississippi Department of Environmental Quality and the Mississippi Department of Health regulations, if applicable, and state laws.

James M. Wells 00005889 1-31-19 James M. Wells
 Print Name of Responsible Licensee and License No. Date Signature of Licensee

STATE WELL REPORT

Part 2

Pump Installer's Completion Report
Mississippi Department of Environmental Quality
Office of Land and Water Resources
P.O. Box 2309
Jackson, MS 39225-2309
(601)961-5210
(601) 360-0535 (fax)

County: Lamar
Permit #: _____
Driller: James M. Wells
Date completed: 12-17-18
Copy information from block on Part 1

For Office Use Only:
Well #: B154
Aquifer: _____

This part of the report must be completed by a licensed water well contractor or a licensed pump installer. A copy of Part 1 of the report must be attached and both parts filed with the Department at the above address within 30 days of well completion.

Well Owner Information	Well Location
Owner Name: <u>Ethan Applewhite</u>	Latitude: <u>31°24.93N</u> Longitude: <u>89°29.35W</u>
Mailing Address: _____	Method of Lat/Long (check one): Conventional Survey _____, ^{21 35.1} ^{32 53 or}
<u>268 Scuggs Rd</u>	USGS quad _____, Hand-held GPS _____, Survey-grade GPS _____
<u>Sumrall</u> MS <u>39482</u>	NE $\frac{1}{4}$ NW $\frac{1}{4}$, Sec <u>31</u> T <u>5N</u> R <u>15W</u>
City State Zip Code	Miles _____ of _____
Telephone No. (____) _____	(Distance) (Direction) (Nearest Town)

Pump Type (circle one)
 Submersible Turbine Air Lift Centrifugal Flowing Well Jet Piston Rotary Other (describe): _____
Date Pump Installed: 12-17-18 Rated Pump Capacity: 12 Gallons Per Minute
Is This Pump (circle one): New Repaired Replacement

Power Type (circle one)
 Electric Diesel Gasoline Natural Gas Tractor PTO Windmill Other (describe): _____
Horse Power Rating of Motor: 1 Setting Depth: 150 feet Number of Stages: 14

Pump Test Data for Non Flowing Well
Date Well Tested: 12-17-18 Duration of Pump Test (minimum 4 hours): 4 hours
Static Water Level (A): 120 Feet Below Land Surface Pumping Water Level (B): 150 Feet Below Land Surface
Drawdown [(B) - (A)]: 125 Feet Below Land Surface Test Pumping Rate: 17 Gallons Per Minute
Method of measurement (circle one): Steel tape Electric tape Air line Other (describe): _____

Pump Test Data for Flowing Well
Measured shut in head: _____ feet.
Well yielded _____ GPM with a drawdown of _____ feet after _____ hours of pumping

Meter Installation
Meter Manufacturer: _____ Meter Serial Number: _____
Meter Model Number/Name: _____ Type of Meter: _____
Totalizer Register Unit and Multiplier Factor (AF x .001, gal x 1000, etc): _____
Installation Date: _____ Meter installed by: _____
Is This Meter (circle one): New Repaired Replacement
Important: By submitting the above information you are certifying that this meter was installed to manufacturer standards. For agricultural wells, a list of approved meters is on the MDEQ website.

I HEREBY CERTIFY that the above statements are true to the best of my knowledge.
James M. Wells 00005889 1-31-19 James M. Wells
Print Name of Pump Installer and License No. (if applicable) Date Signature of Pump Installer