STATE WELL REPORT					
County: Lamar	Part 1 Driller's Log Mississippi Department of Environmental Quality		For Office Use	Only:	
Driller: Josh Boone Date drilling completed: 07/27/2021	Office of Land and Water Resources P.O. Box 2309 Jackson, MS 39225-2309 (601)961-5555		Aquifer:	RECEIVED	
(601)961-5555 (601)961-5228 (fax) State Law requires that this report be prepared by the license holder responsible for the work and filed with the Department at the above address within 30 days of completion of drilling of the well or borehole.					
Well Owner Information (Landowner if borehole is not for a water well) Owner Name: Davis smith		Well or Borehole Location Latitude: 31.4259010 Longitude: -89.4933490 Method of Lat/Long (check one): Conventional Survey,		3490	
Mailing Address: 09 DIG TITI TO		USGS quad, Hand-held GPS, Survey-grade GPS			
		<u>NW</u> 1/4 <u>SE</u> 1/4, Sec_ Miles <u>(Distance)</u>			
	Well / B	orehole Data			
Date drilling started: 07/27/2021 Date drilling completed: 07/27/2021 Hole depth: 300 Hole diameter: 7.25 Location of the source of any surface water used for drilling: Running creek Method of dosing and volume of Chlorine used in drilling and development: Granulated chlorine Logs run (check all applicable): No log run Electric Gamma Ray Density Sonic Neutron Other: Name of organization running log(s): Purpose of borehole (check one): Water Well 🖸 Geotechnical/Geological Investigation Ground Source Heat Pump Seismic Survey Other (describe) If drilling is not related to water well construction, skip the remainder of this block					
Purpose of Well (check all applicable):       Home Industrial       Public Supply       Irrigation       Fish Culture         Other (describe):					
Screen length: <u>10</u> feet S Screen slot size: <u>8</u> inches Type of completion (check all applicabl	[ above or ⊵beld (check one) Steel tape Electric depth of: <u>10</u> f asing diameter: <u>4</u> creen diameter: <u>4</u> Setting depth: e): Gravel packed⊆	ow] land surface Date measur tape Air line Other ( <i>describe</i> ) eet Type of grout (check <i>one</i> ) inches Type of c inches Type of f From 290feet to Underreamed Open hole	ed: 07/27/202 .: .: 	21 onite Mix Dt	
Other ( <i>describe</i> ): Top of lap pipe or reduction in casing:feet If telescoped or more than one screen, describe on next page					

	_
County: Lamar	
Permit #:	



For Office Use Only:

Well #: <u>B163</u>

The sketch below only required for water wells

Description of formations encountered must be provided for all wells and boreholes, unless specifically exempted by regulations

Description of Formations Encountered	From (depth)	To (depth)
Top soil	Ground level	3
Clay	3	78
Sand	78	82
Clay	82	225
Sand	225	300

If more than one screen, show location of each on sketch


Sketch the property layout and include the following:

1) the well location

2) any permanent structures on the property that may aid in locating the well

3) any roads, power lines, or other items that may aid in locating the property and the well

4) north arrow

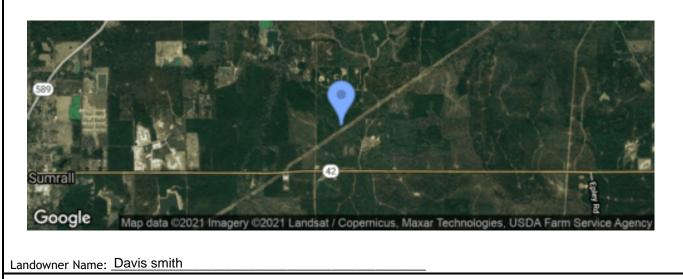

I HEREBY CERTIFY that the well/borehole was drilled, constructed, and completed in accordance with all applicable requirements of the Mississippi Department of Environmental Quality and the Mississippi Department of Health regulations, if applicable, and state laws.

Josh Boone 8683 Print Name of Responsible Licensee and License No. 09/03/2021 Date Signature of Licensee

Form: OLWR-SWR-1B (4/13)

If well telescopes, show depths on sketch.

K

Ground Level