

LAMAR
C 50
2-8-61

MISSISSIPPI BOARD OF WATER COMMISSIONERS

WATER WELL DRILLERS LOG **CODED**

Date: 2-8, 1961, Driller: Jay Rott County: Lamar
(Name)

(1) Owner of Land:	Description & Color of Materials Sand, Clay, Red Clay, Shell, etc.	Thick- ness Feet	Depth Feet
<u>Jay Rott</u> (Name) <u>Rt. 3 Dumas</u> (Address)	<u>Red Sand</u>		<u>20</u>
(2) Location: <u>1/4</u> , <u>1/4</u> , Sec. <u>16</u> T <u>9R</u> <u>16</u>	<u>" Clay</u>		<u>20-40</u>
<u>9</u> miles <u>North</u> of <u>Dumas</u> (distance) (direction) (Nearest Town)	<u>" Sand</u>		<u>40-50</u>
(3) Topography: <u>Hilly</u> (Hilly) (Flat) (Level)	<u>white "</u>		<u>50-60</u>
(4) Purpose of Well: <u>HOUSE</u> (Domestic Irrigation Municipal, Industrial, Other)			

Information upon completion of well:


- (1) Diameter 2" inches.
- (2) Total Depth 60 feet.
- (3) Water Level 45 feet below top of ground.
- (4) Cased to bottom Size 2"
- (5) Screen: Size 3", Length 5ft
- (6) Were any formations sealed against pollution?
 yes, no.

If YES depth of formation _____

Why _____

Drillers Remarks: _____

CODED

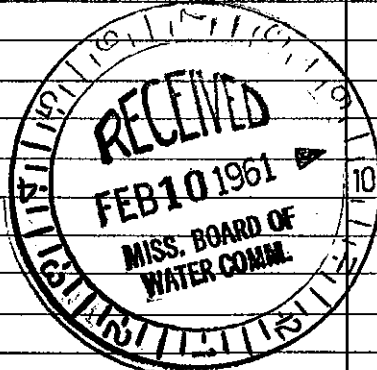

Well No.

(Use Back Side)

Mail this copy to Board of Water Commissioners 429 Miss. St. Jackson, Miss