

LAMAR MISSISSIPPI BOARD OF WATER COMMISSIONERS

C51
2-14-63

WATER WELL DRILLERS LOG


Date: 2-14, 1963, Driller: E. B. SHERRARD County LAMAR
(Name)

(1) Owner of Land:	Description & Color of Materials Sand, Clay, Red Clay, Shell, etc.	Thick- ness Feet	Dep Feet
<u>Dewey PACE</u> (Name) <u>O'LOH, MISS</u> (Address)	RED CLAY		20
	SAND GRAVEL		40
(2) Location: <u>1/4</u> , <u>1/4</u> , Sec. <u>T</u> <u>R</u>	<u>GRAY CLAY</u>	<u>60</u>	<u>80</u>
<u>15</u> miles <u>E</u> , of <u>COLUMBIA</u> (distance) (direction) (Nearest Town)		<u>100</u>	<u>120</u>
(3) Topography: <input checked="" type="checkbox"/> (Hilly) <input type="checkbox"/> (Flat) <input type="checkbox"/> (Level)	<u>WATER SAND</u>	<u>100</u>	<u>160</u>
(4) Purpose of Well: <u>Domestic</u> (Domestic Irrigation Municipal, Industrial, Other)			

Information upon completion of well:

- (1) Diameter: 2 inches.
- (2) Total Depth: 150 feet.
- (3) Water Level: 70 feet below top of ground.
- (4) Cased to _____, Size _____
- (5) Screen: Size 2", Length 5'
- (6) Were any formations sealed against pollution?
_____ yes, _____ no.

If YES depth of formation _____
Why _____
Drillers Remarks: _____

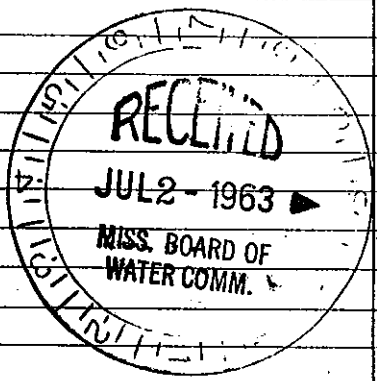

Well No.

(Use Back Side)

Retain this copy for your office files.