


LAMAR MISSISSIPPI BOARD OF WATER COMMISSIONERS

C52
6-11-64

WATER WELL DRILLERS LOG

Date: June 11, 1964, Driller: Jay Patt County Lamar
Hattiesburg (City)

(1) Owner of Land: <u>Roseae Bonds</u> (Name)	Description & Color of Materials Sand, Clay, Red Clay, Shell, etc.	Thick- ness Feet	Depth Feet
<u>Mc Comb, Miss.</u> (Address)	<u>we</u>	<u>0</u>	<u>8</u>
(2) Location: <u>1/4, 1/4, Sec. T R</u>	<u>ws</u>	<u>8</u>	<u>12</u>
<u>20 miles West</u> of <u>Hattiesburg</u> (distance) (direction) (Nearest Town)	<u>we</u>	<u>12</u>	<u>25</u>
(3) Topography: _____ (Hilly) (Flat) (Level)	<u>ws</u>	<u>25</u>	<u>30</u>
(4) Purpose of Well: <u>Domestic</u> (Domestic Irrigation Municipal, Industrial, Other)	<u>we</u>	<u>30</u>	<u>35</u>
Information upon completion of well:	<u>rc</u>	<u>35</u>	<u>73</u>
(1) Diameter <u>2</u> inches.	<u>93</u>	<u>320</u>	<u>330</u>
(2) Total Depth <u>333</u> feet.	<u>330</u>	<u>330</u>	<u>333</u>
(3) Water Level <u>68</u> feet below top of ground.			
(4) Cased to _____, Size _____			
(5) Screen: Size <u>2"</u> , Length <u>10ft.</u>			
(6) Were any formations sealed against pollution? _____ yes, _____ no.			
If YES depth of formation _____			
Why _____			
Drillers Remarks: _____			

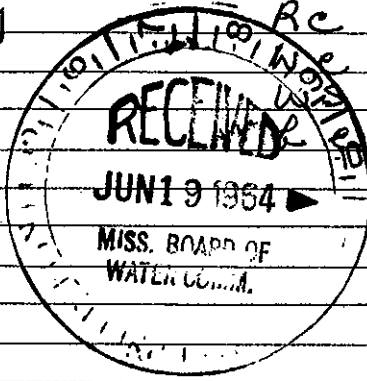

Well No.

(Use Back Side)

Mail this copy to Board of Water Commissioners 429 Miss. St. Jackson, Miss.