

Lamar
C 53

MISSISSIPPI BOARD OF WATER COMMISSIONERS

11-66

WATER WELL DRILLERS LOG

Date: 11-11, 1966, Driller: J & R Drilling Co., County: Lamar
1047 Thompson Blvd. (Address) (Name) (City) (State) (Zip)


(1) Owner of Land: J.F. Crosby (Name)
P.O. Box 7, Summit Miss (Address)
(2) Location: 1/4, 1/4, Sec. 21, T4R16, N W
1 1/2 miles east of Columbus (distance) (direction) (Nearest Town)
(3) Topography: Hilly (Hilly) (Flat) (Level)
(4) Purpose of Well: Home (Domestic Irrigation, Municipal, Industrial, Other)

Description & Color of Materials Sand, Clay, Red Clay, Shell, etc.	Thick- ness Feet	Depth Feet
Red clay	10	10
Fire sand	10	20
Sand & gravel	10	30
Big gravel	20	50
Fire sand	10	60
Good sand	15	75

Information upon completion of well:

(1) Diameter 2 inches.
(2) Total Depth 75 feet.
(3) Water Level 41 feet below top of ground.
(4) Cased to 70, Size 2"
(5) Screen: Size 2", Length 5 ft.
(6) Were any formations sealed against pollution?
yes, no.

If YES depth of formation _____
Why _____
Drillers Remarks: _____

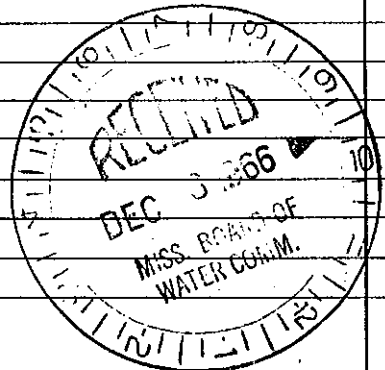

(Use Back Side)

Well No.